


FINAL PROOF SURVEY

IN
T40 & 41S R14 & 14½ EWM

APPLICATION NOS UNDER PERMIT NOS
R 7397 R 628
7398 9416
R22973 R 979
R22974 R 980
R22975 R 981
22976 18863

IN NAME OF
WILLOW VALLEY IRRIGATION DISTRICT
SURVEYED 11, 12 & 13 MAY 1955 BY H. L. COFFMAN

--- IRRIGATION DITCH
- - - DRAIN DITCH

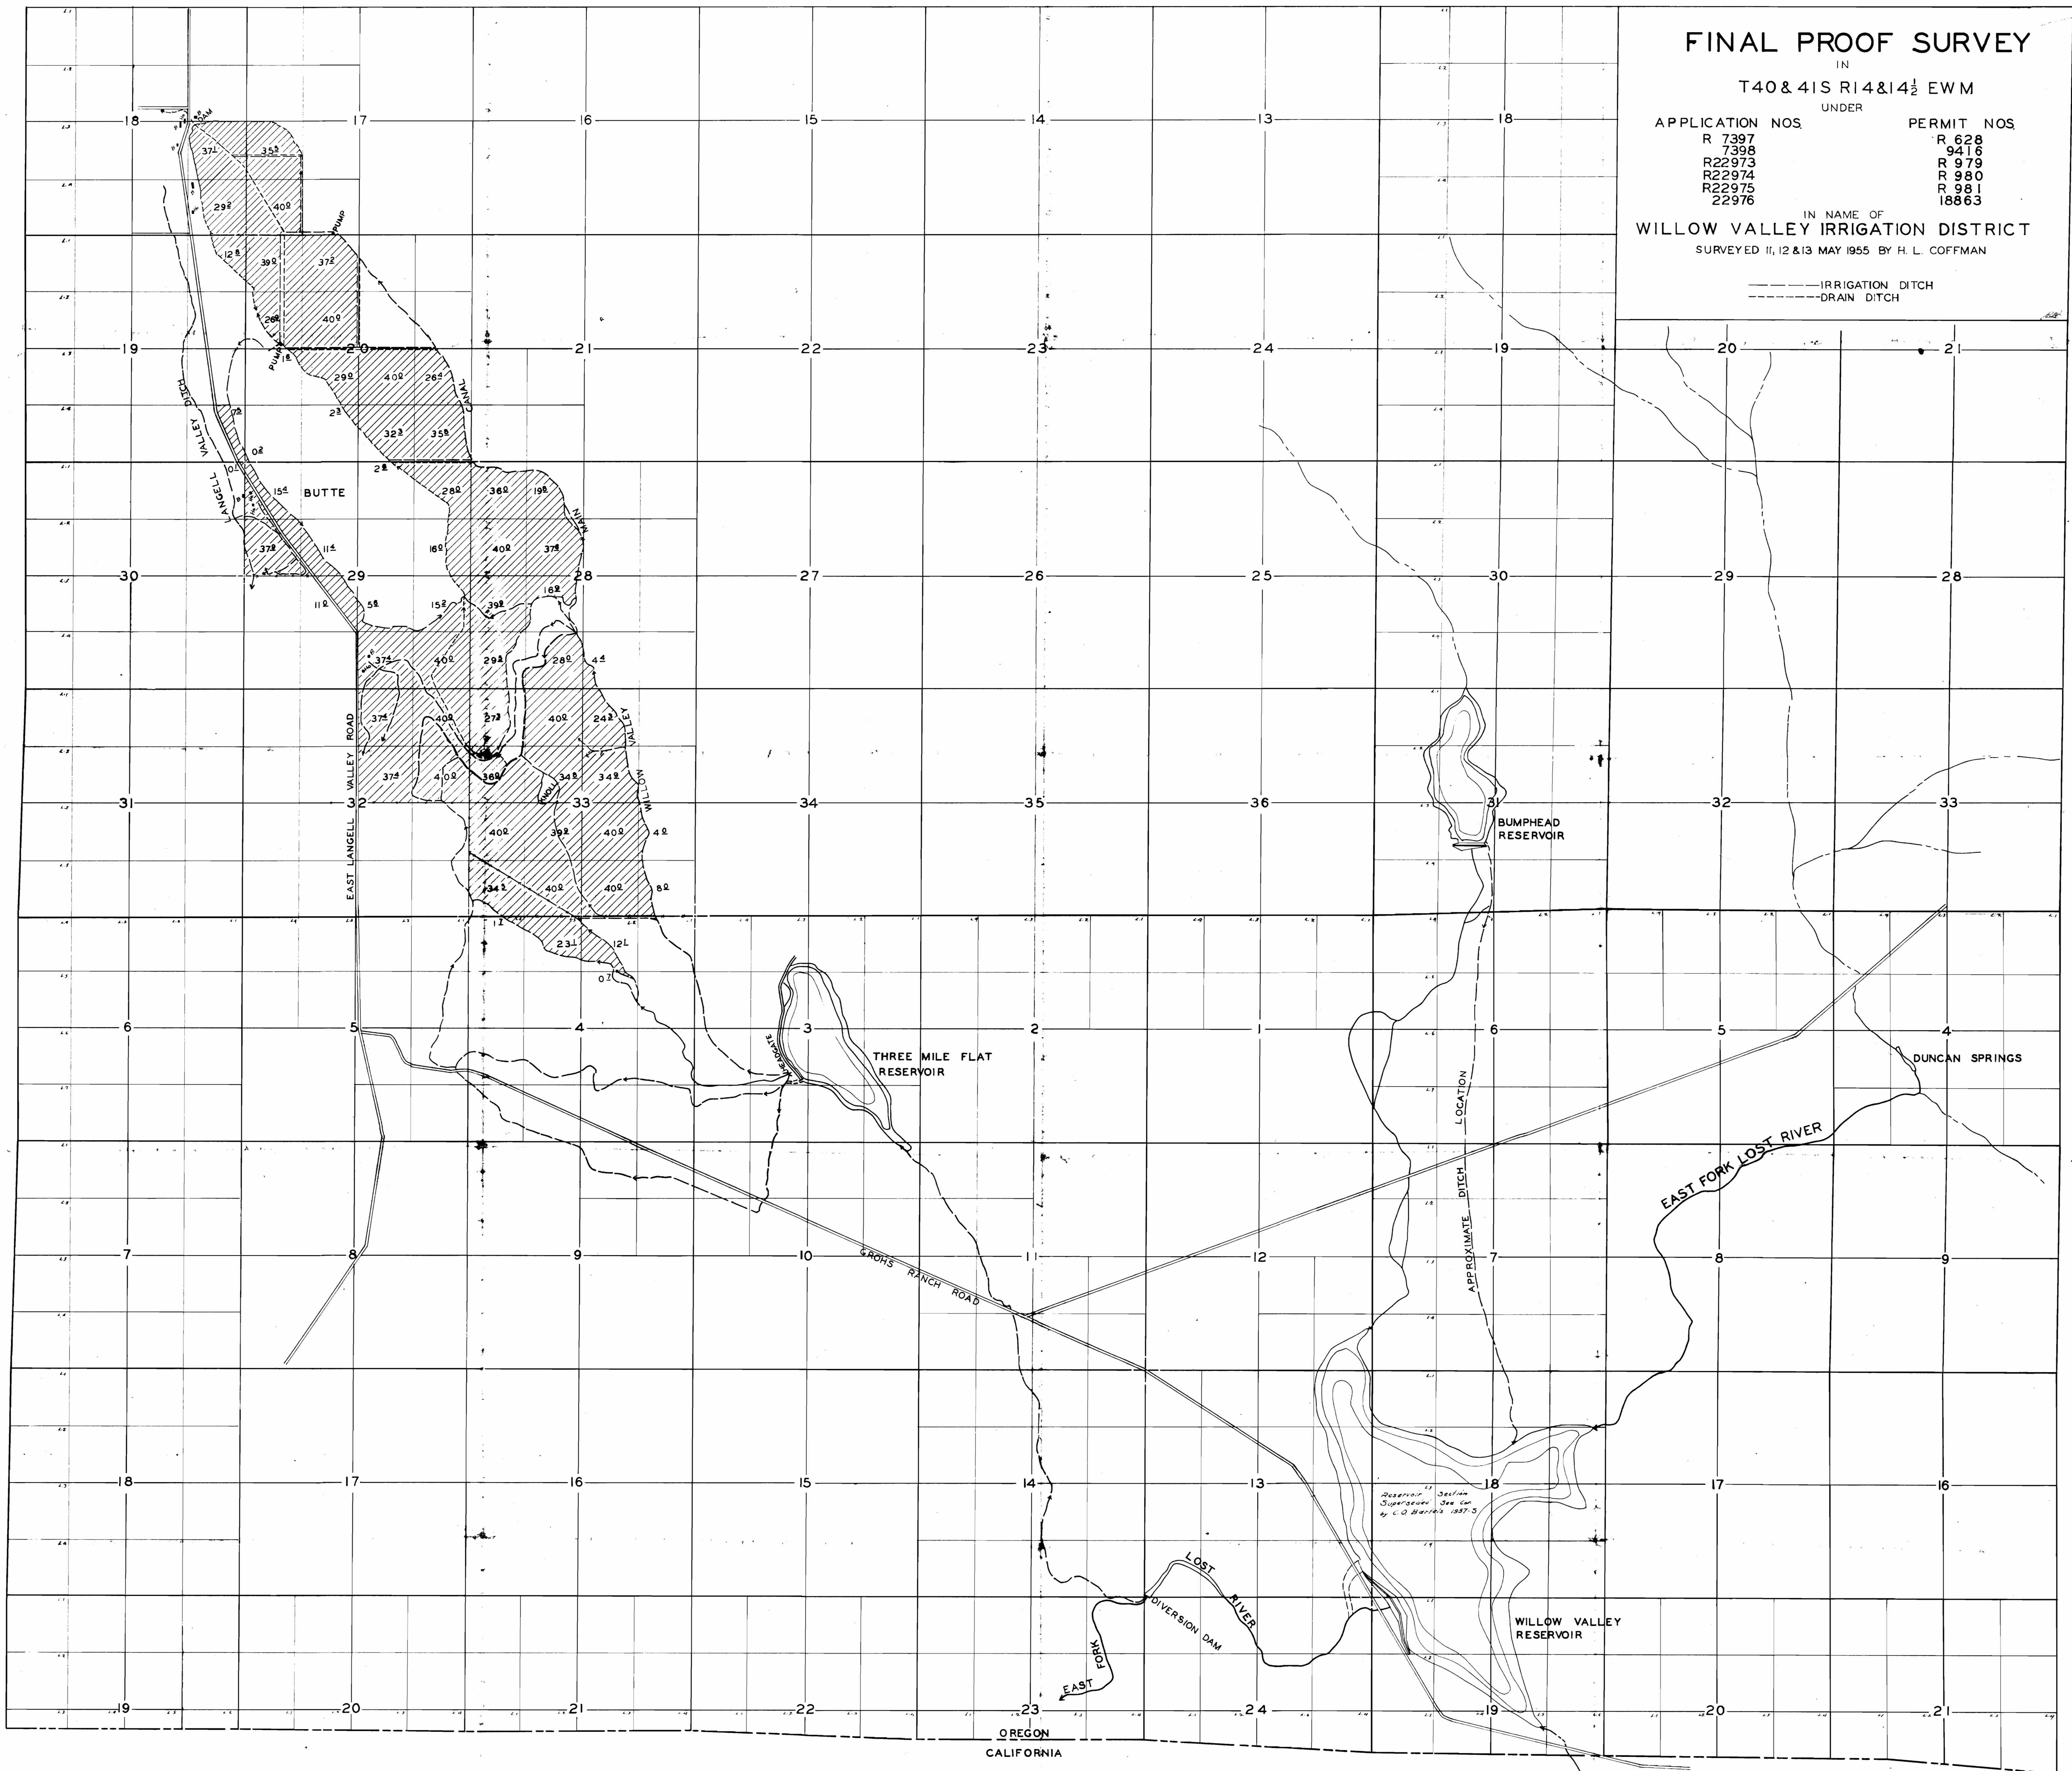

OREGON
CALIFORNIA