


FINAL PROOF SURVEY

IN
T40 & 41S R14 & 14½ EWM
UNDER

APPLICATION NOS	PERMIT NOS
R 7397	R 628
7398	9416
R22973	R 979
R22974	R 980
R22975	R 981
22976	18863

IN NAME OF
WILLOW VALLEY IRRIGATION DISTRICT
SURVEYED 11, 12 & 13 MAY 1955 BY H. L. COFFMAN

--- IRRIGATION DITCH
--- DRAIN DITCH

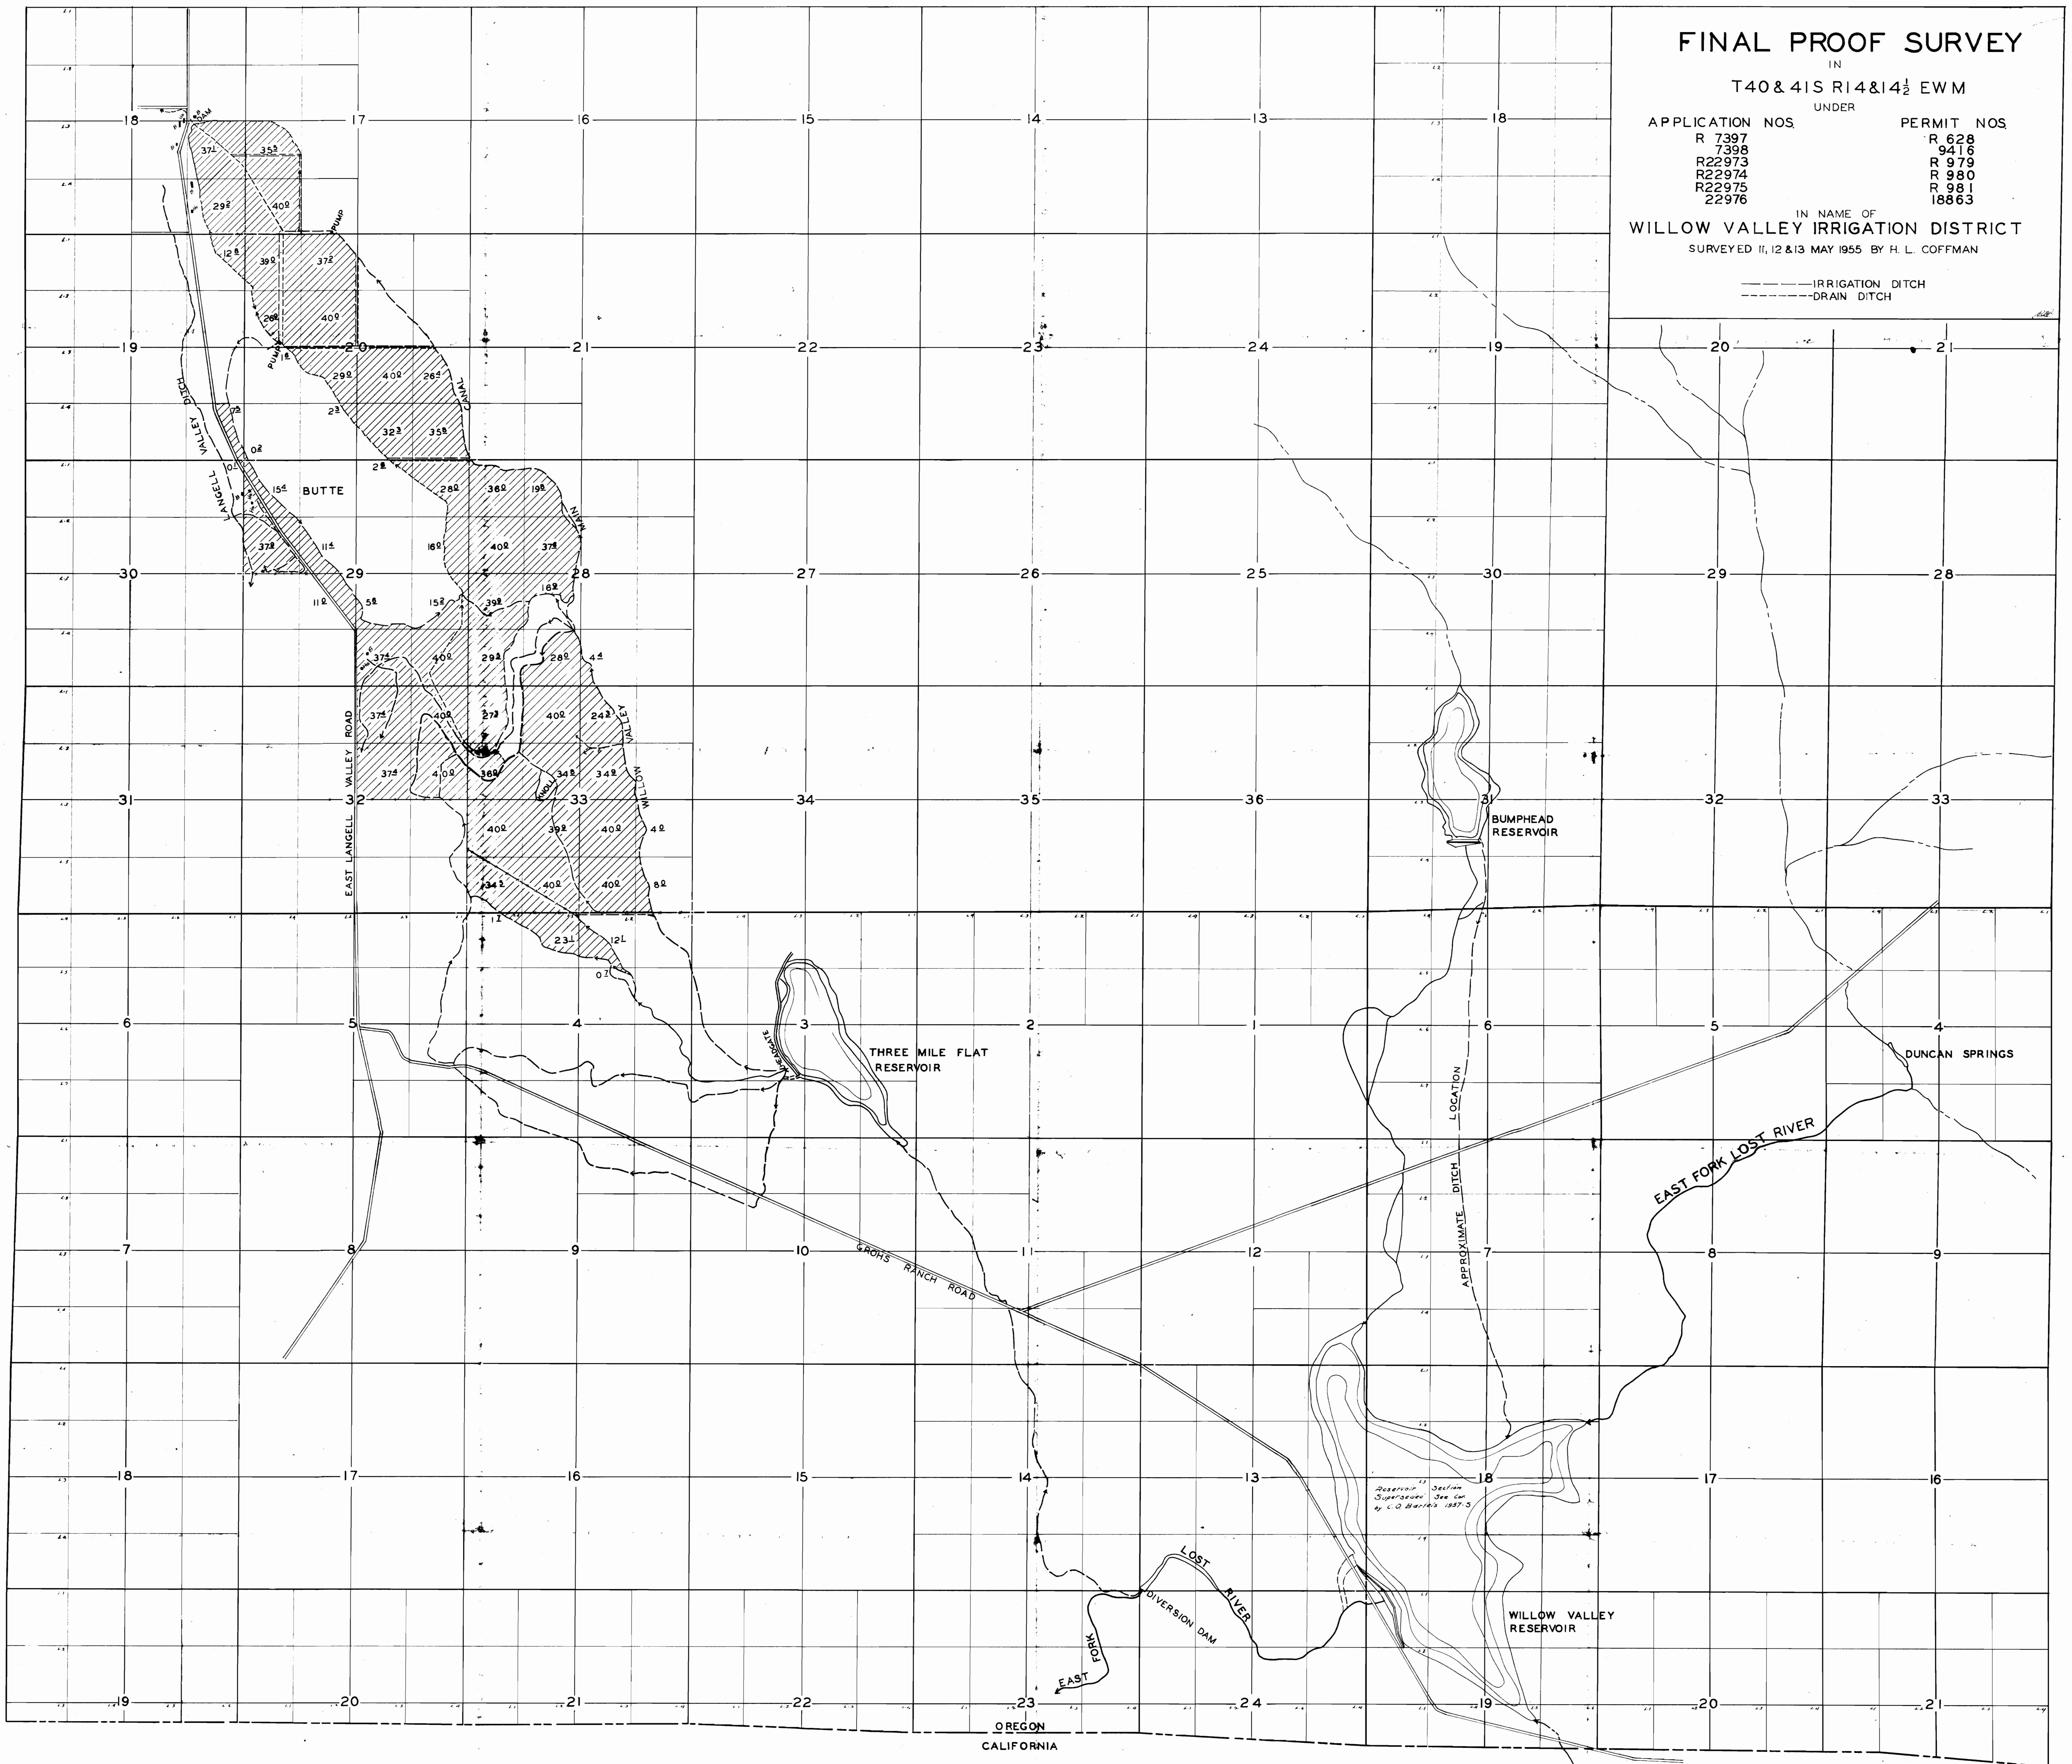

OREGON
CALIFORNIA