


T.36S.R.24E.W.M.

292

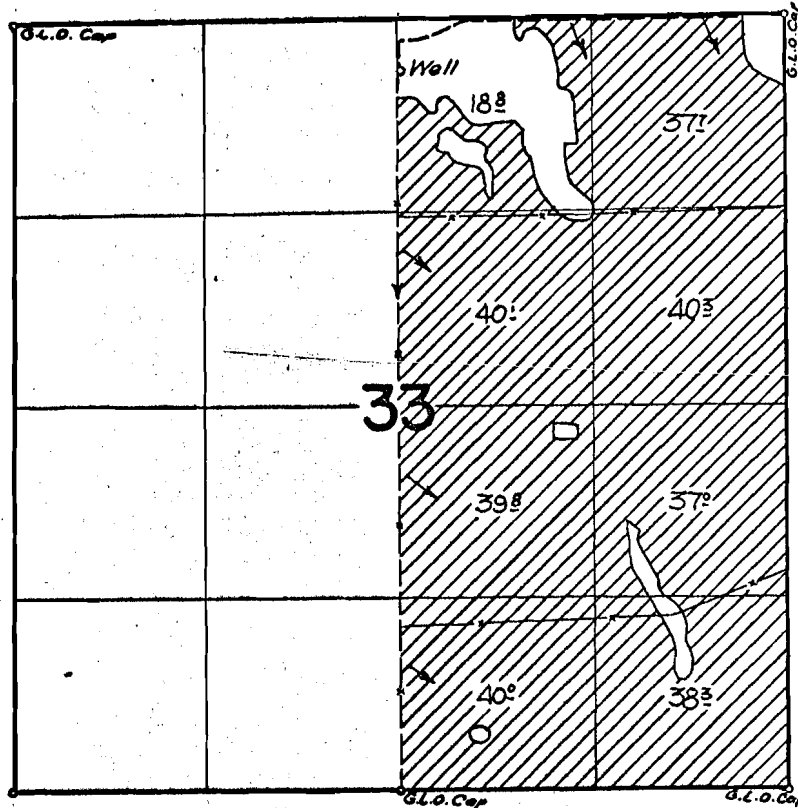

FINAL PROOF SURVEY UNDER

Application No. G-1297... Permit No. G-1185...
IN NAME OF

.....TAYLOR RANCH, INC.

Surveyed Sept. 11, 1962, by *[Signature]*