


T. 18 S.R. 47 E.W.M.

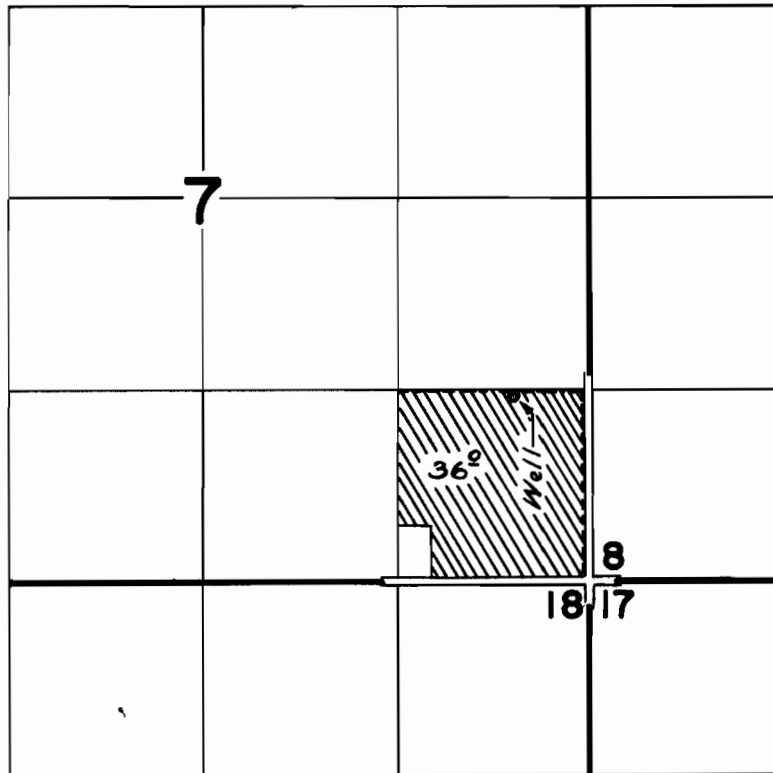

FINAL PROOF SURVEY
UNDER

Application No. G-1166 Permit No. G-1154
IN NAME OF

Clarence H. Lee

Surveyed June 7 1962, by C.R. Baker