


T. 18 S.R. 45 E.W.M.

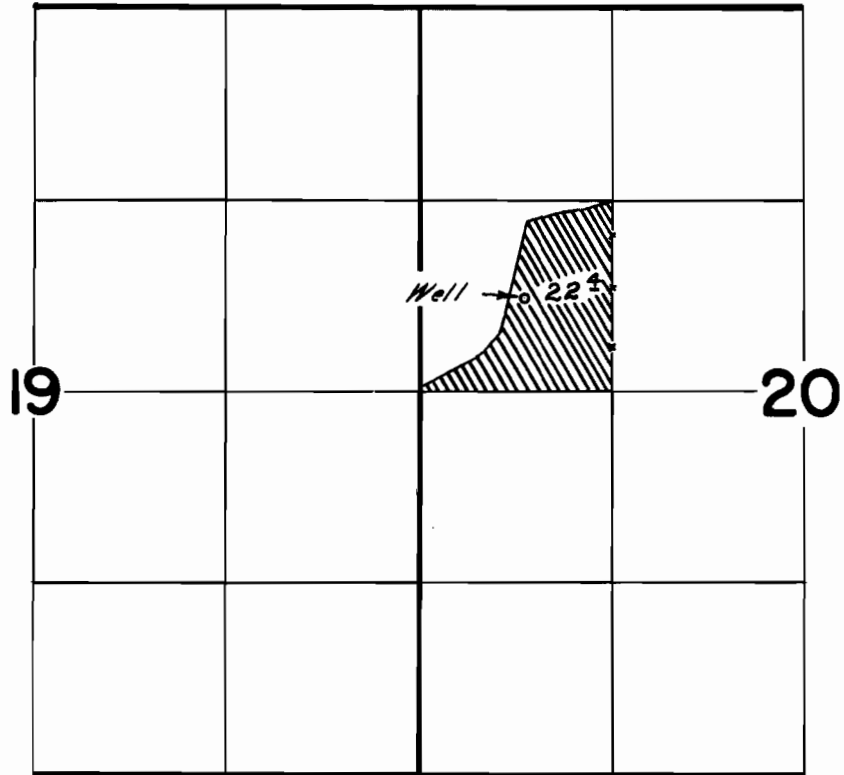

FINAL PROOF SURVEY
UNDER

Application No. *G-1352* Permit No. *G-1231*
IN NAME OF

J.J. FULLER

Surveyed *June 8* 1962, by *C.R. Baker*