


T. 1S. R. 3E. W.M.

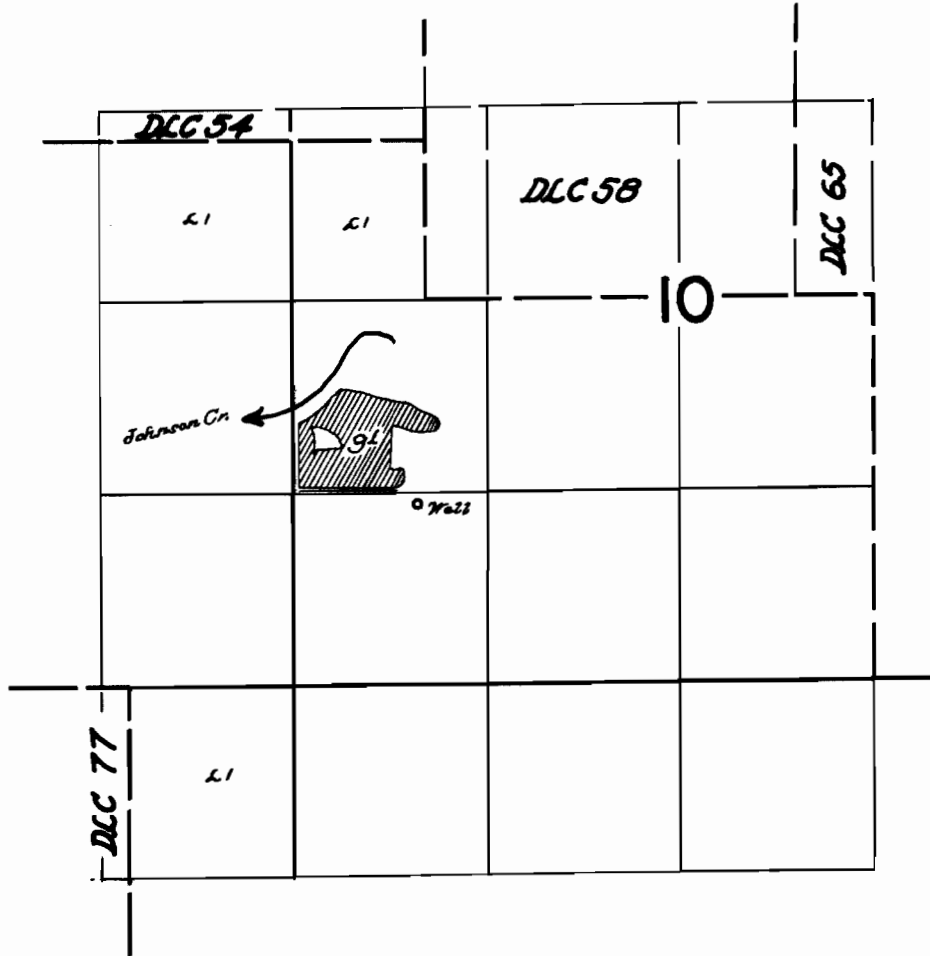

FINAL PROOF SURVEY UNDER

Application No. G-1301 Permit No. G-1223
IN NAME OF

Forest Lawn Memorial Park

Surveyed June 29 1962, by Thomas F. Lauer