


T. 7&8S. R. 4W.W.M.

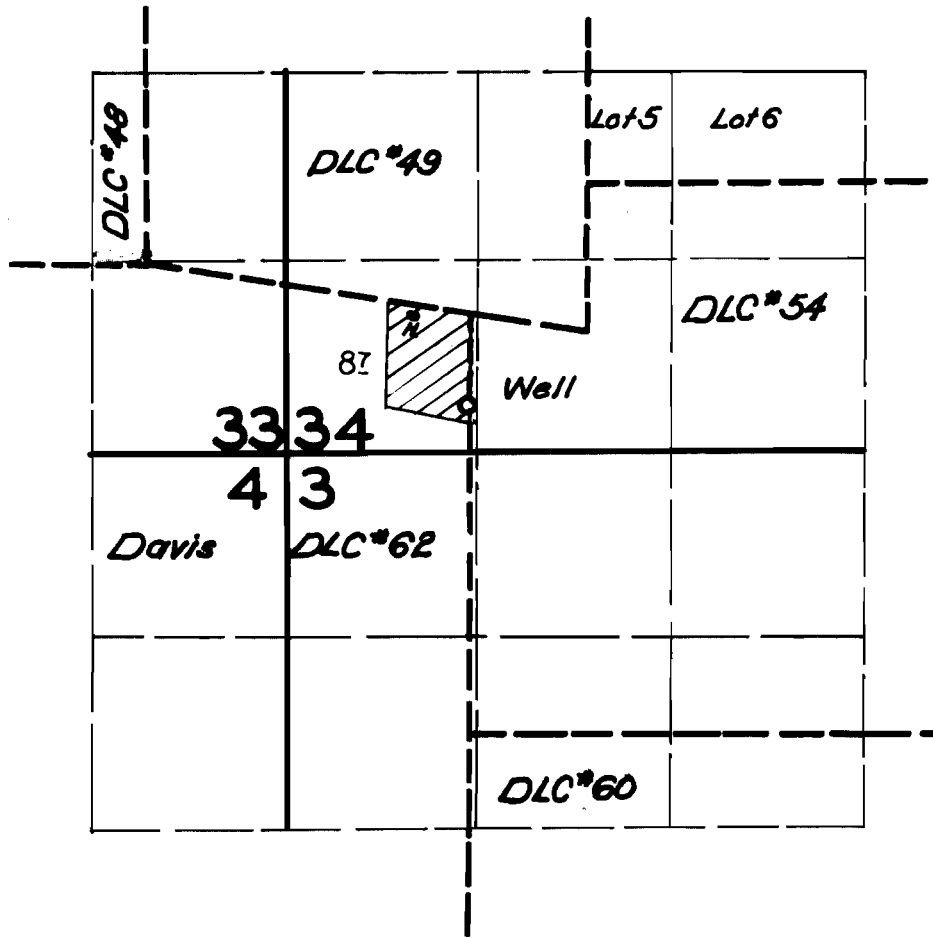

FINAL PROOF SURVEY  
UNDER

Application No. *G-1095* Permit No. *G-948*  
IN NAME OF

*Paul J. Wedel*

Surveyed *21 June* 1962., by *Carl R. Baker*