


T.7S.R.5W.W.M.

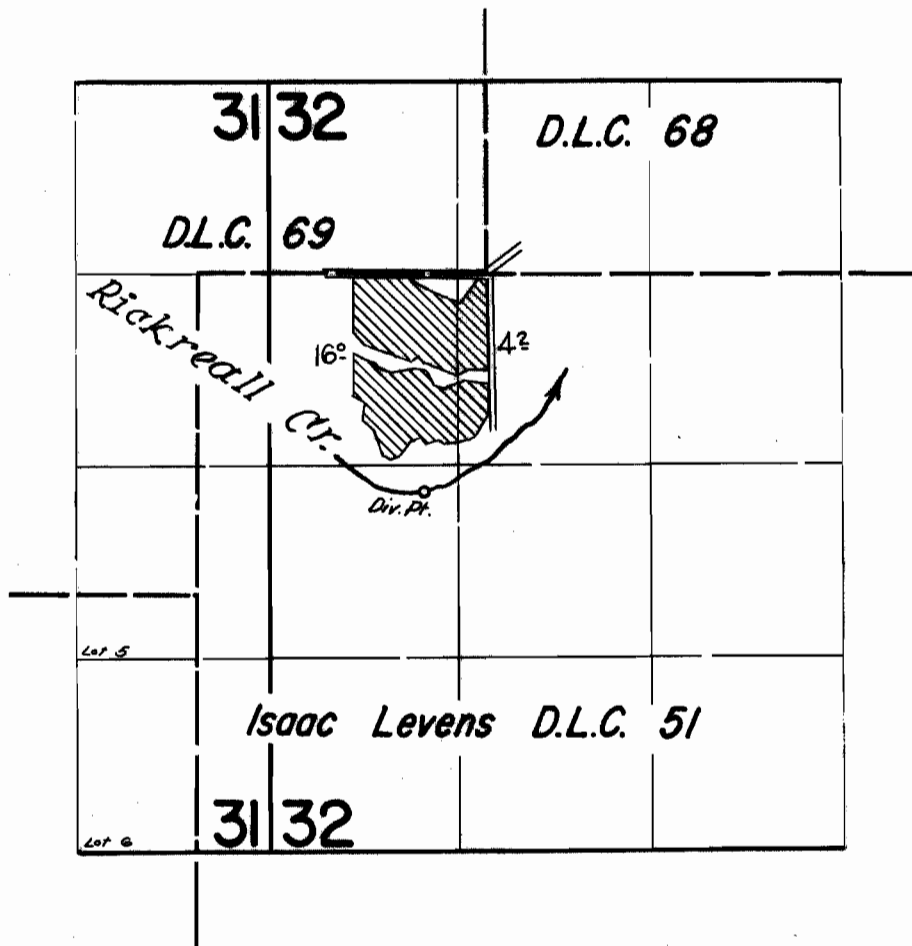

FINAL PROOF SURVEY
UNDER

Application No. 33638... Permit No. 26592...
IN NAME OF

JAMES R. BOYDSTON

Surveyed June 19, 1963, by Carl R. Baker