


T.3S.R.10W.W.M.

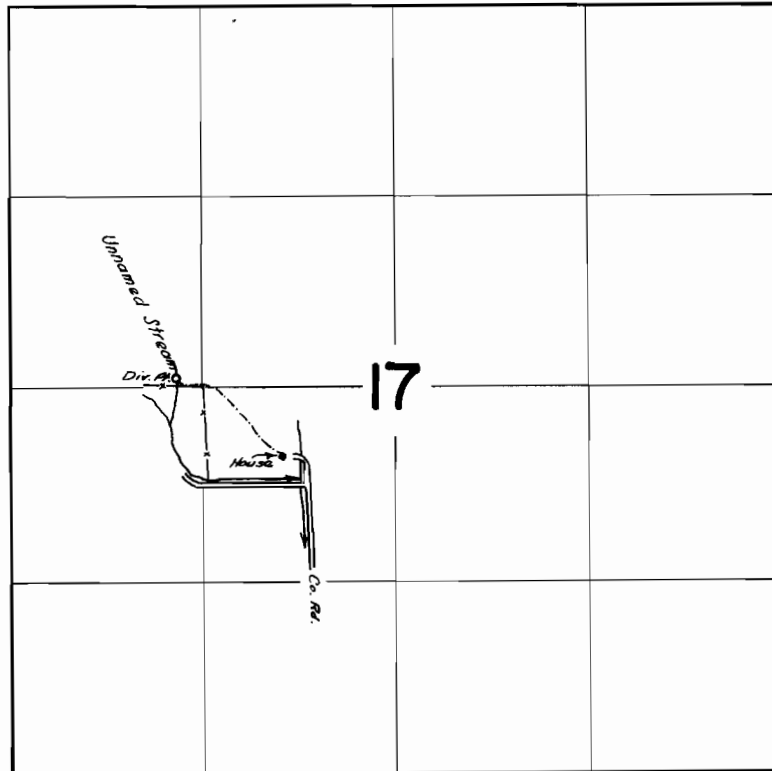

FINAL PROOF SURVEY
UNDER

Application No. **32136** Permit No. **25350**
IN NAME OF

JOHN E. & BETTY A. BUCKBEE

Surveyed August 2, 1962, by *A. Jackson*