


T.4N.R.27E.W.M.

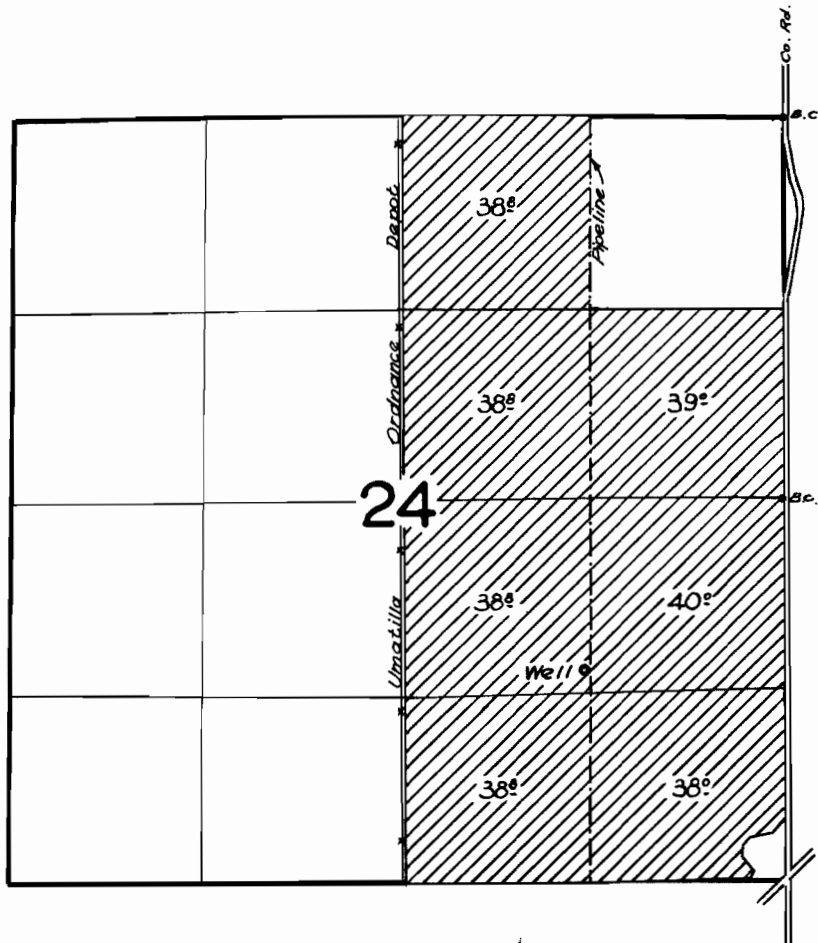

**FINAL PROOF SURVEY**  
UNDER

Application No. **6-111** Permit No. **6-73**  
IN NAME OF

**CHARLES R. JACKSON**

Surveyed June 12 & 13 1962, by *Ch. Jackson*