


7

T.6N.R.35E.W.M.

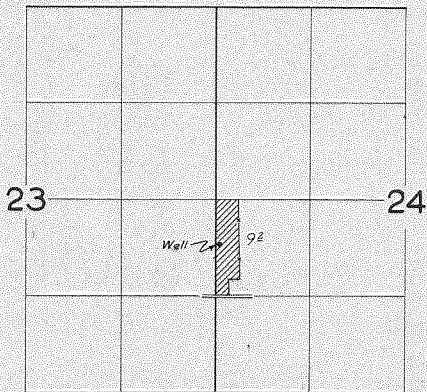

FINAL PROOF SURVEY
UNDER

Application No. **G-770** Permit No. **G-673**
IN NAME OF

A. E. BAKER

Surveyed April 30 1962, by

A. Jackson