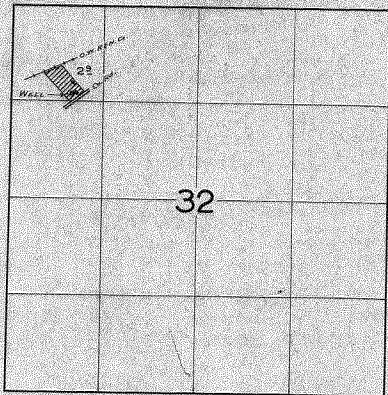


7

G-727

31274

T.3N.R.33E.W.M.

FINAL PROOF SURVEY
UNDERApplication No. G-810 Permit No. G-727
IN NAME OF

JUDITH KAY & JACKIE LYNN MCCLURE

Surveyed June 14, 1962, by *Apelton*