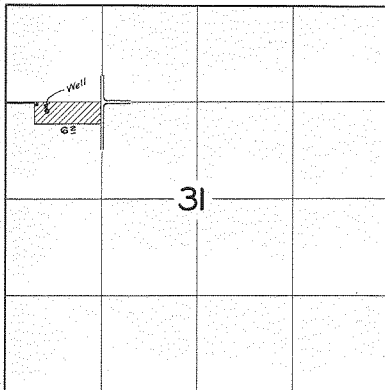


7

T.6N.R.36E.W.M.

**FINAL PROOF SURVEY**
UNDERApplication No. **G-930** .. Permit No. **G-851** ..
IN NAME OF**ELLIS O. PRATT**Surveyed May 1, 1962, by *H. Johnson*