


T.6N.R.35E.W.M.

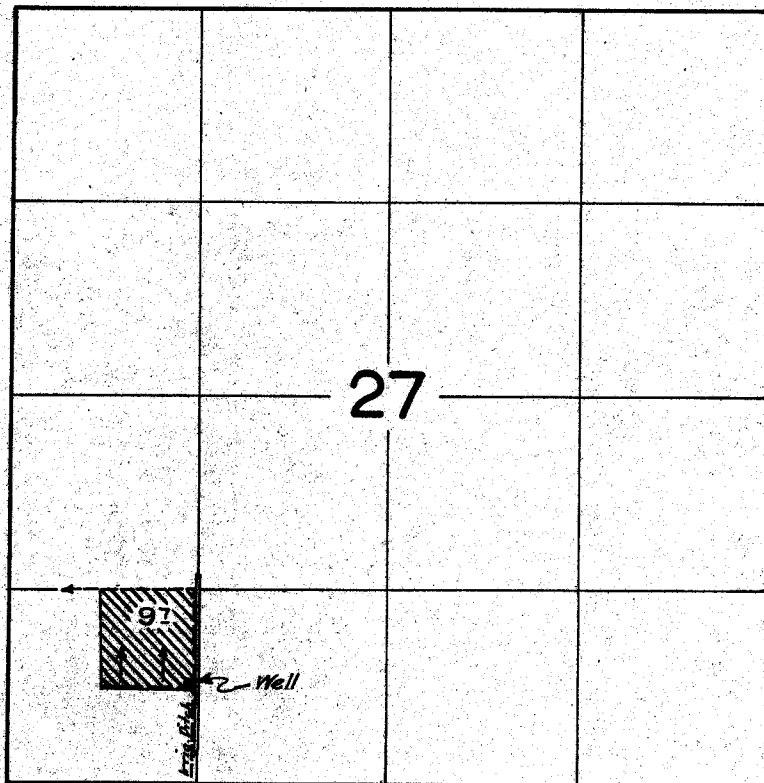

FINAL PROOF SURVEY UNDER

Application No. G-984 Permit No. G-892
IN NAME OF

MRS. MARIE F. HARRIS

Surveyed April 26 1962, by *L. J. Jackson*