


7

T.6N.R.35E.W.M.

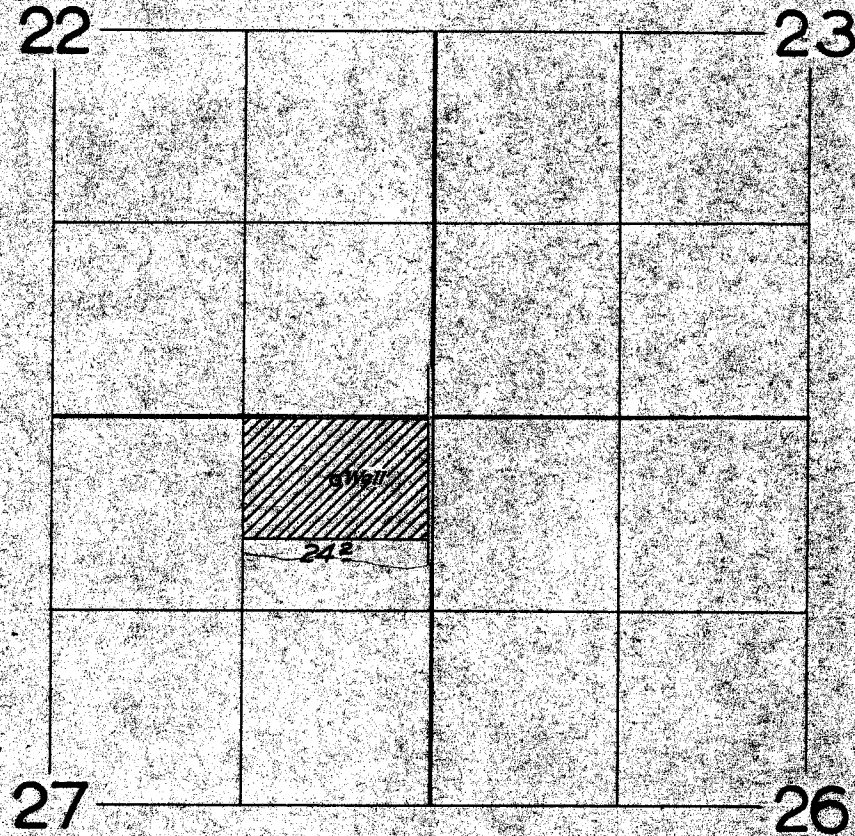

FINAL PROOF SURVEY UNDER

Application No. G-1042 Permit No. G-908
IN NAME OF

IDA NORRIS

Surveyed April 24 1962, by *[Signature]*