


7

T.6N.R.35E.W.M.

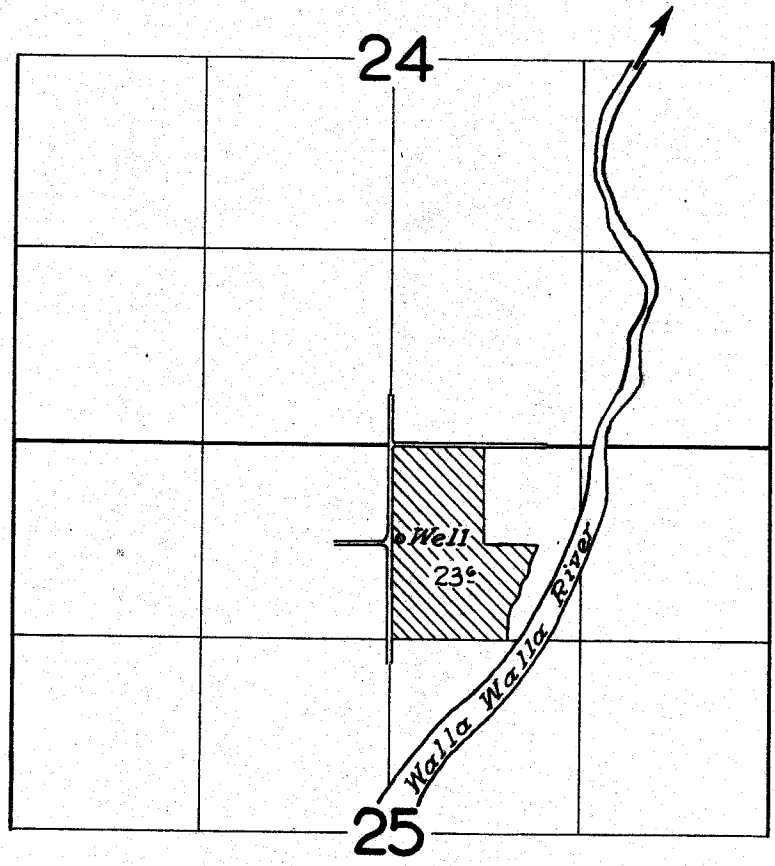

FINAL PROOF SURVEY
UNDER

Application No. G-1122 Permit No. G-955
IN NAME OF

DEE GOODWIN

Surveyed May 3 1962, by *A. Jackson*