


7

# T.6N.R.35E.W.M.

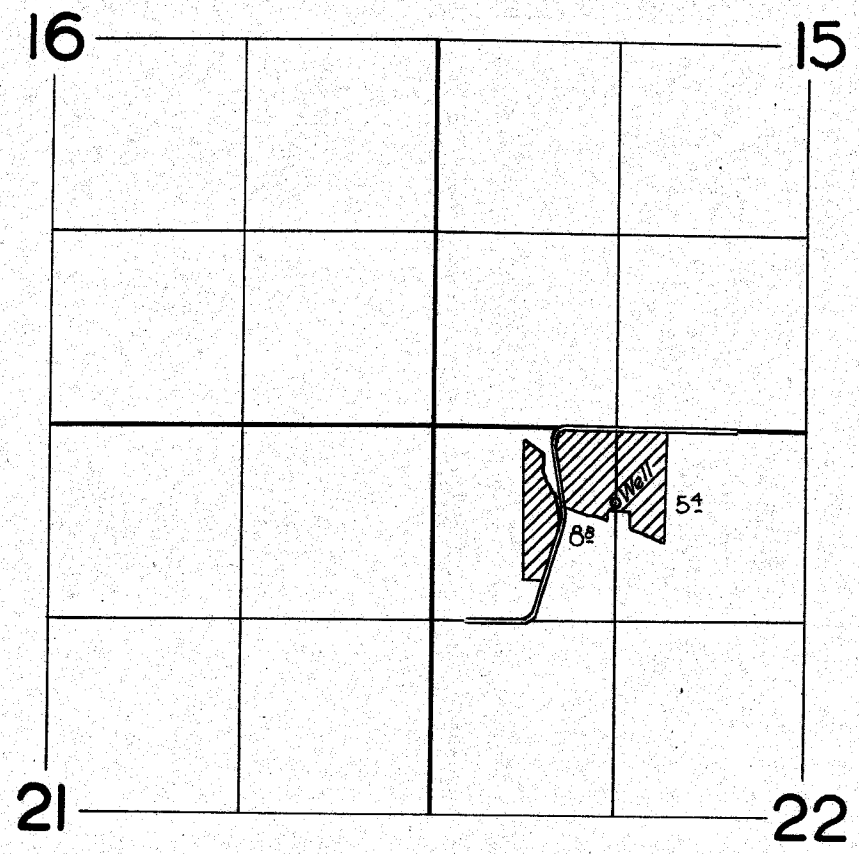

## FINAL PROOF SURVEY UNDER

Application No. **G-1004** Permit No. **G-973**  
IN NAME OF

**FRANK J. PARENT**

Surveyed April 25 1962, by *R. Jackson*