


T.6N.R.35E.W.M.

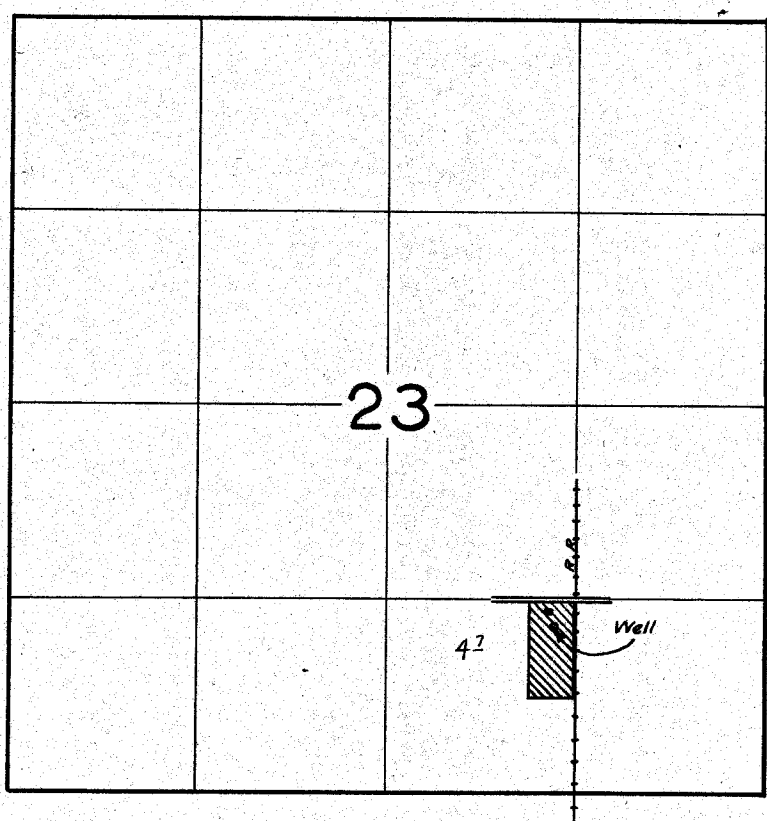

FINAL PROOF SURVEY UNDER

Application No. **G-1027** Permit No. **G-1023**
IN NAME OF

HERBERT J. FOX

Surveyed April 24 1962, by *A. Jackson*