


7

G-1146
31281

T.6N.R.35E.W.M.

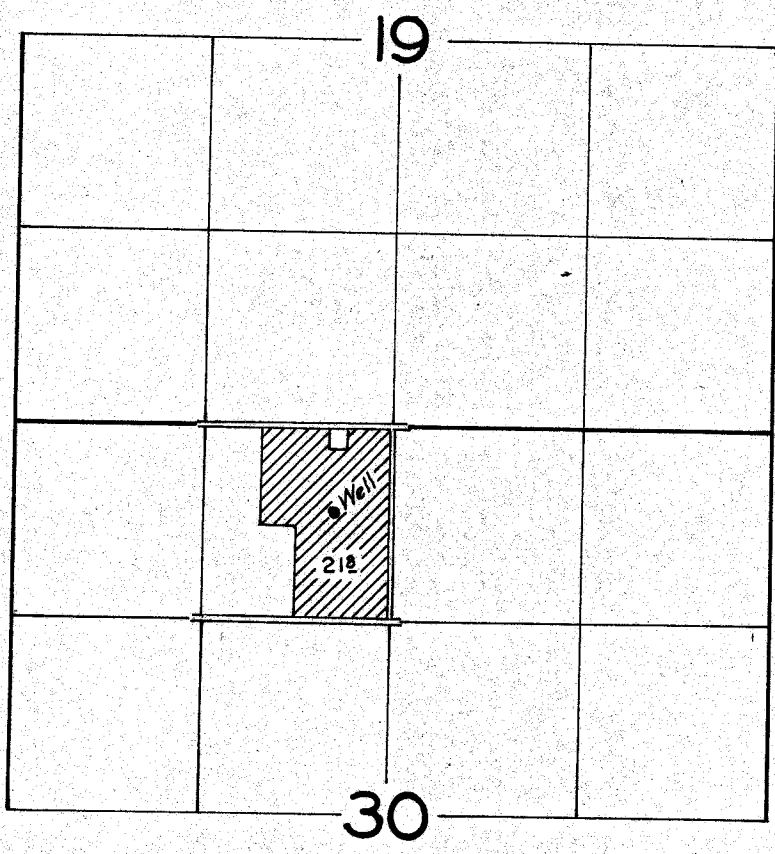

FINAL PROOF SURVEY UNDER

Application No. G-1016... Permit No. G-1146...
IN NAME OF

Carl L. & Anita J. Harris

Surveyed *May 1*... 1962., by *Alpeko*