


T.5N.R.29E.W.M.

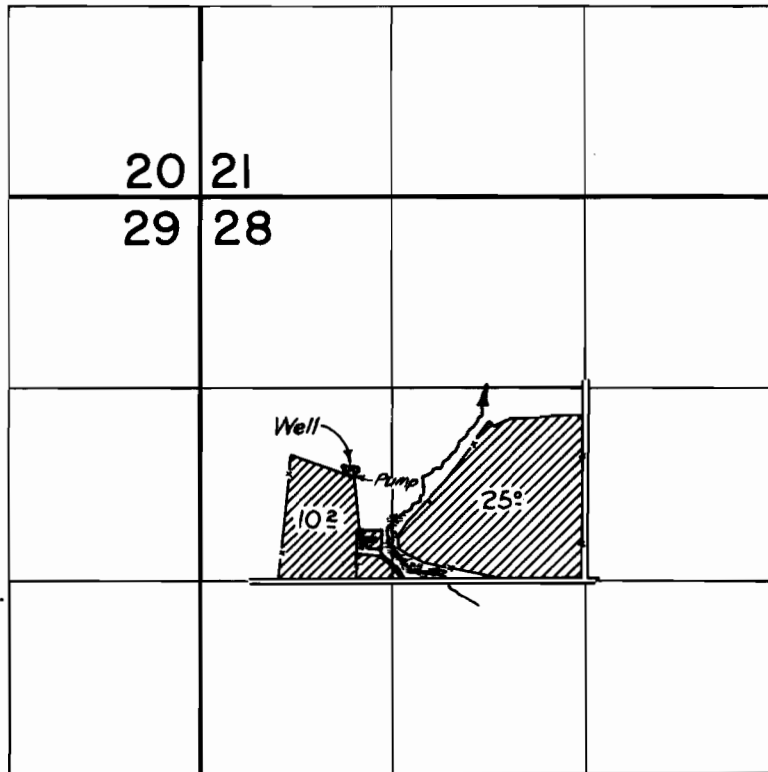

FINAL PROOF SURVEY UNDER

Application No. 6-1298 Permit No. 6-1164
IN NAME OF

Donald De Moss

Surveyed June 7 1962, by A. Jackson