


T.6N.R.35E.W.M.

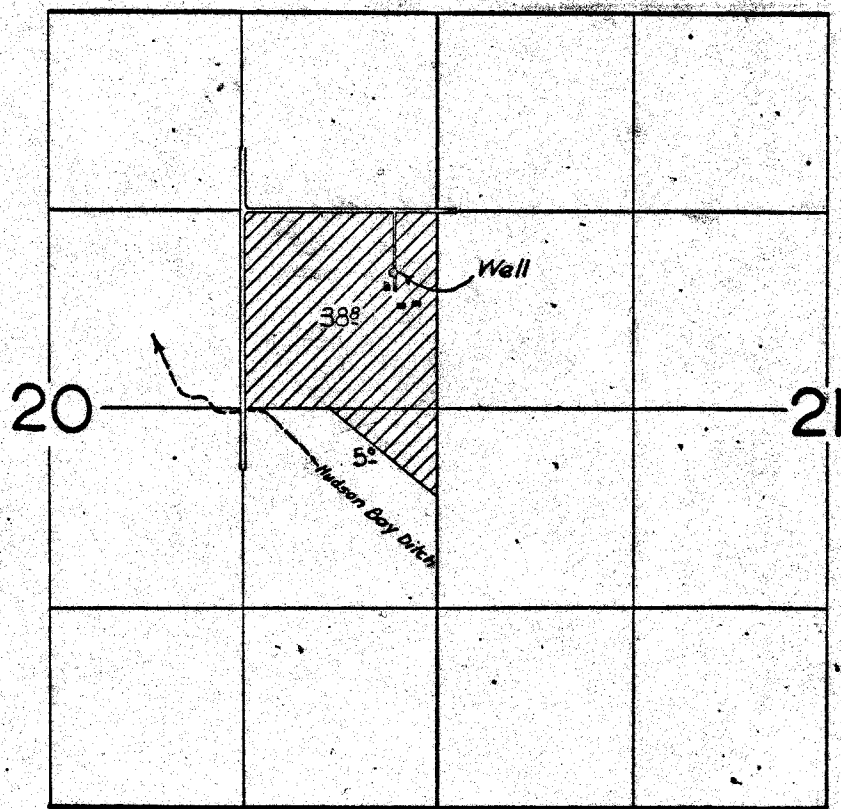

FINAL PROOF SURVEY UNDER

Application No. G-1378... Permit No. G-1217...
IN NAME OF

MRS. R. H. HOODENPYLE

Surveyed April 25, 1962., by *A. Jackson*