


7

G-1245

31284

T.4N.R.29E.W.M.

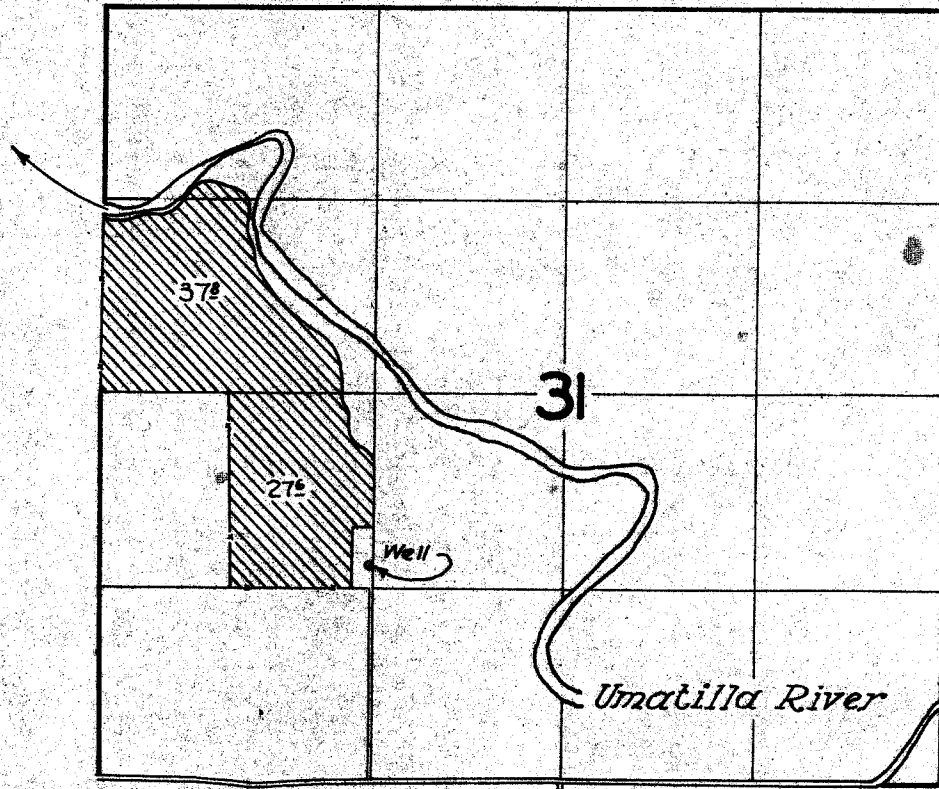

FINAL PROOF SURVEY UNDER

Application No. **G-1373** Permit No. **G-1293**
IN NAME OF

GLADYS CRUM

Surveyed June 9, 1962, by *[Signature]*