


T.5N. R.28E. W.M.

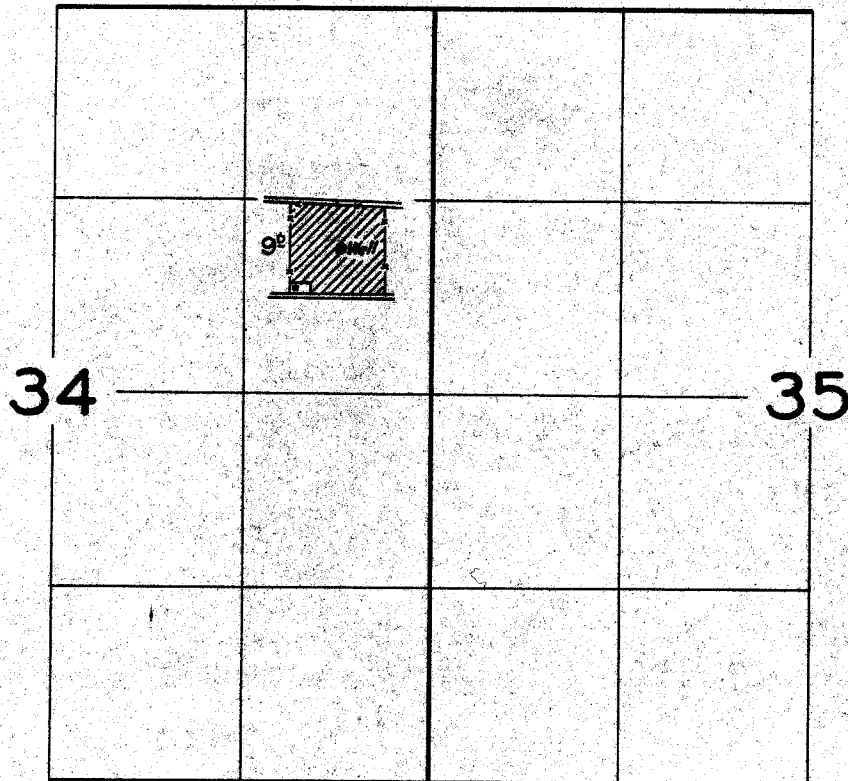

UT 1
1966 D

FINAL PROOF SURVEY UNDER

Application No. G-1438 Permit No. G-1314
IN NAME OF

S. W. & FLORENCE STEWART

Surveyed June 12 1962, by R. Jackson