


T.6N.R.35E.W.M.

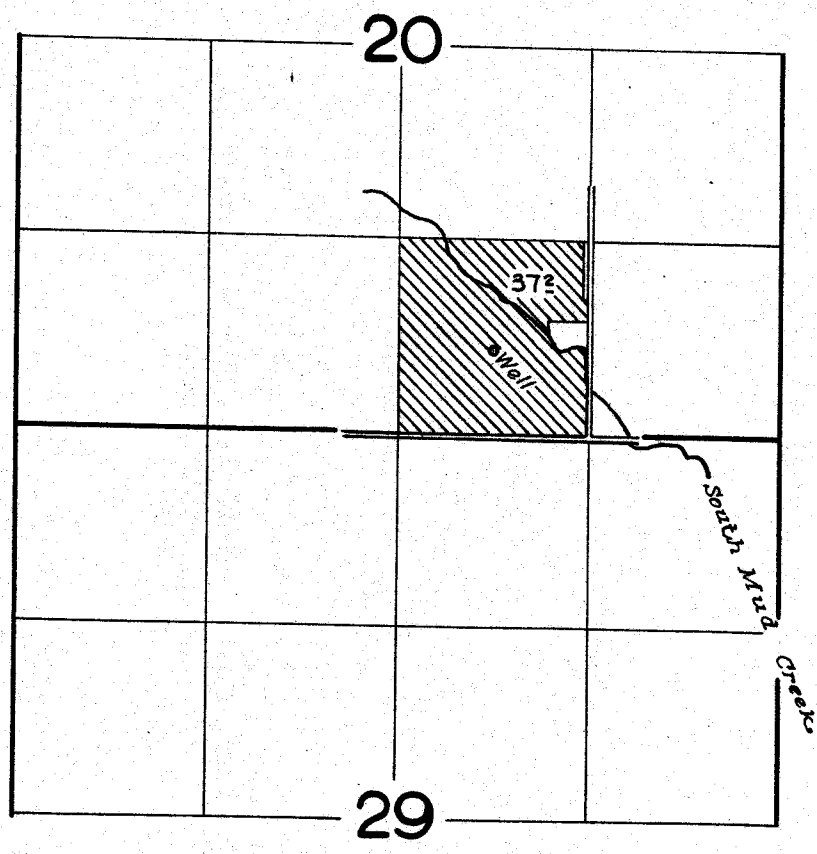

FINAL PROOF SURVEY UNDER

Application No. **G-1978** Permit No. **G-1814**
IN NAME OF

R. P. LILE

Surveyed May 2 1962, by *R. Jackson*