


# T.6N.R.35E.W.M.

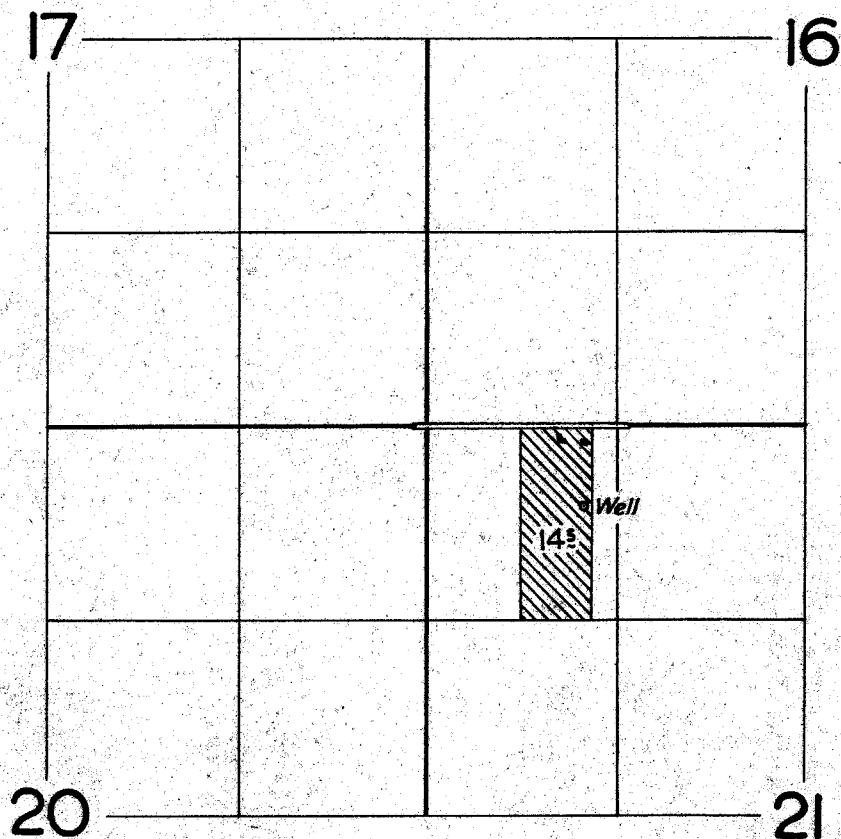

## FINAL PROOF SURVEY UNDER

Application No. G-2142 Permit No. G-1978  
IN NAME OF

**LEHMAN C. & JEANNE C. MEGY**

Surveyed April 25 1962, by *[Signature]*