


-6- Pen 24957
31291
T.5S.R.31E.W.M.

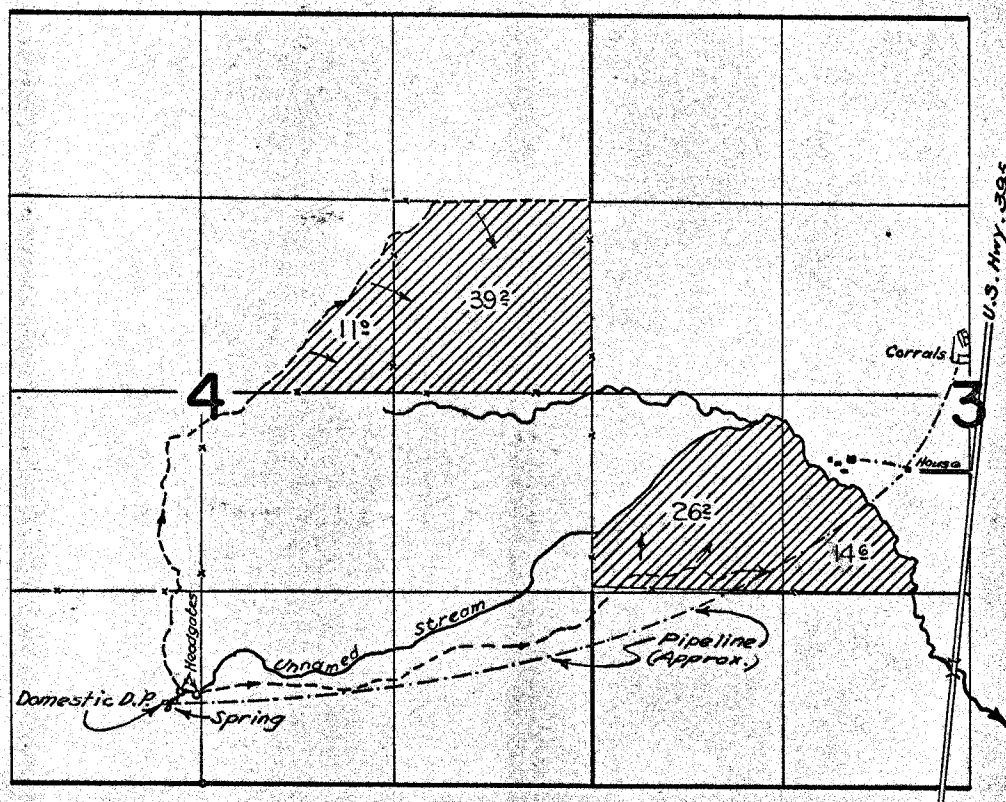

FINAL PROOF SURVEY
UNDER

Application No. 31470... Permit No. 24957...
IN NAME OF

J. P. FRENCH

Surveyed June 8, 1962, by *R. Jackson*