


T.4N.R.28E.W.M.

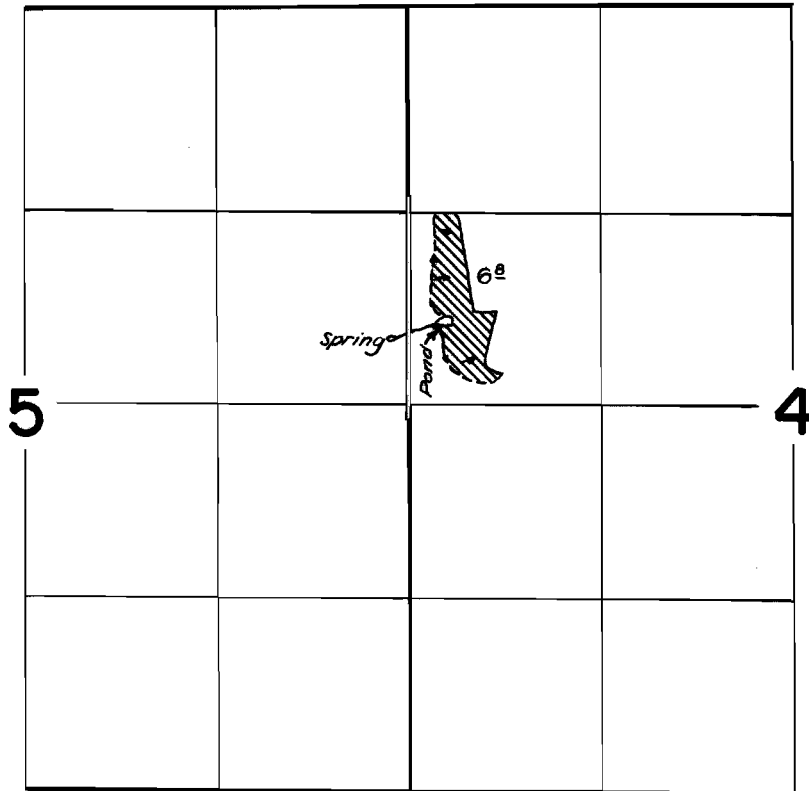

FINAL PROOF SURVEY
UNDER

Application No. **32877** Permit No. **26114**
IN NAME OF

THOMAS SNYDER

Surveyed June 13, 1962, by *R. Jackson*