


T.3N.R.28E.W.M.

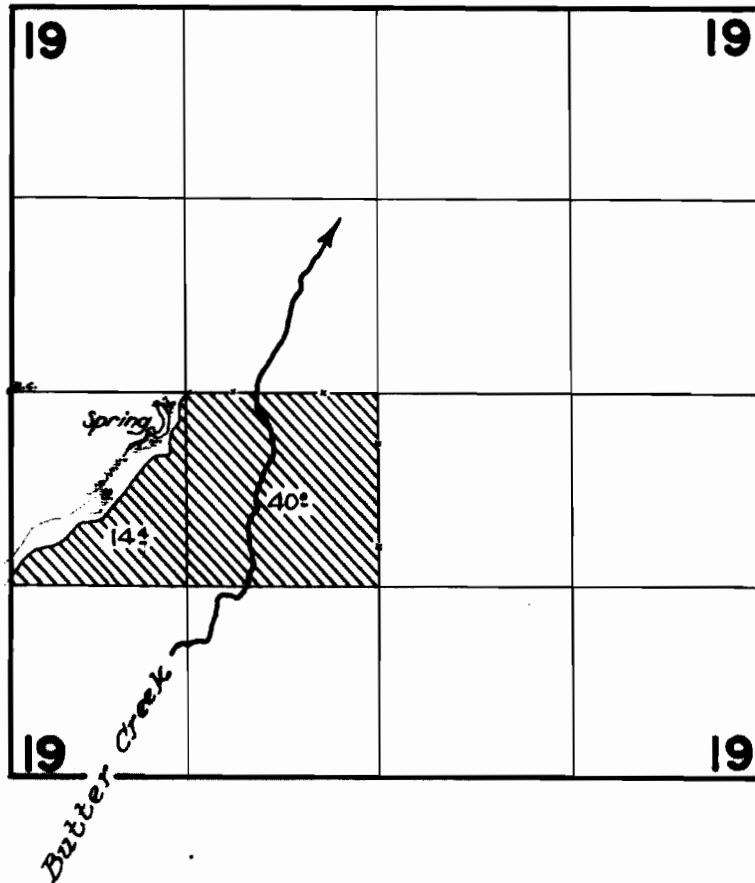

FINAL PROOF SURVEY
UNDER

Application No. 30751 Permit No. 26320
IN NAME OF

RALPH G. SAYLOR

Surveyed June 13 1962, by *Ralph G. Saylor*