


T.4N.R.29E.W.M.

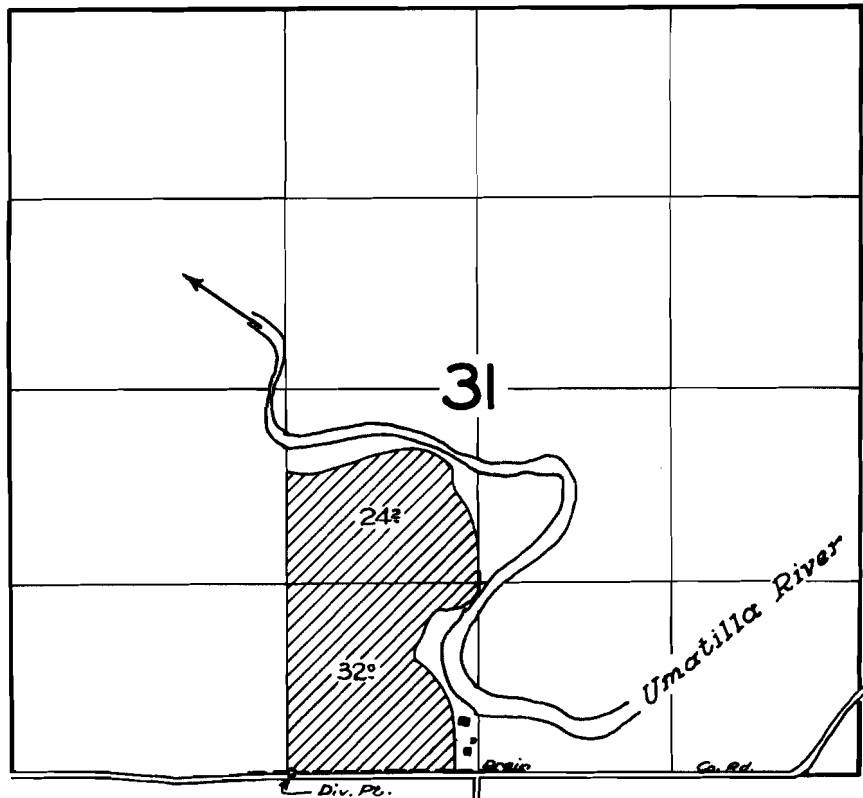

**FINAL PROOF SURVEY**  
UNDER

Application No. **33580** Permit No. **26564**  
IN NAME OF

**BLANCHE KENISON**

Surveyed June 9, 1962, by *[Signature]*