


T.4N.R.28&29E.W.M.

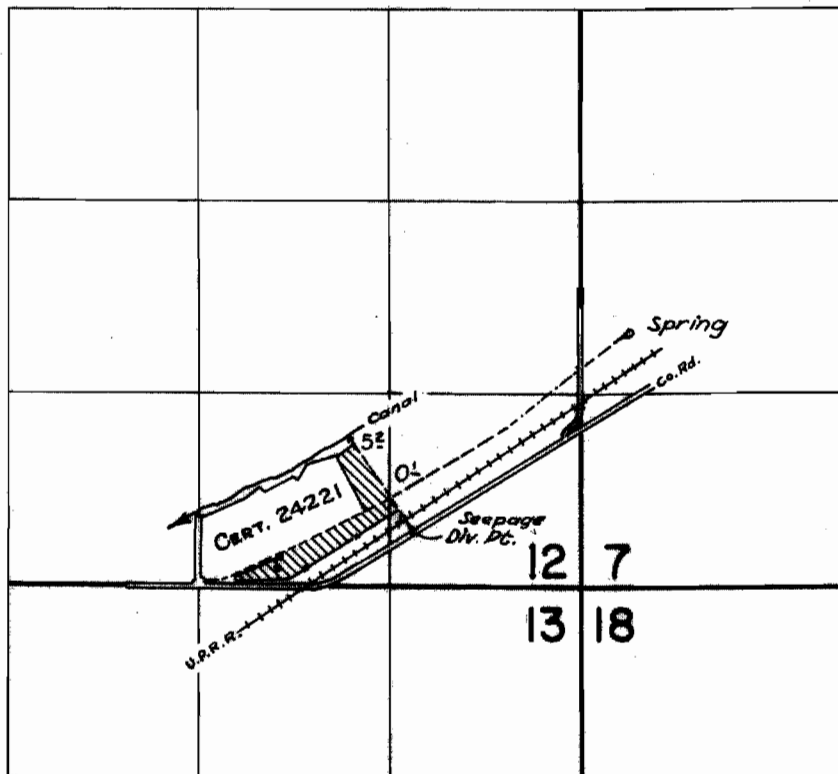

FINAL PROOF SURVEY UNDER

Application No. **34008** Permit No. **26991**...
IN NAME OF

WILMER MOORE

Surveyed June 9, 1962, by *Alpekson*