


T.1S. R.2W.W.M.

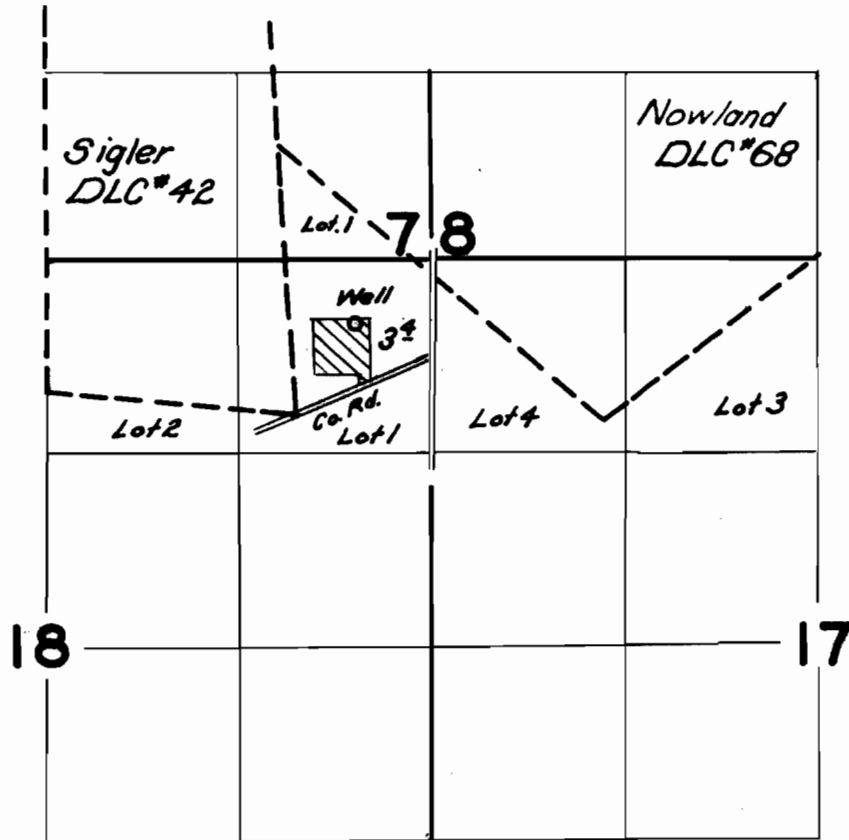

FINAL PROOF SURVEY
UNDER

Application No. *G-1280* Permit No. *G-1126*
IN NAME OF

Walter A. Brown

Surveyed *25 Oct.* 1962, by *Carl R. Baker*