


T. I. S. R. I. W. W. M.

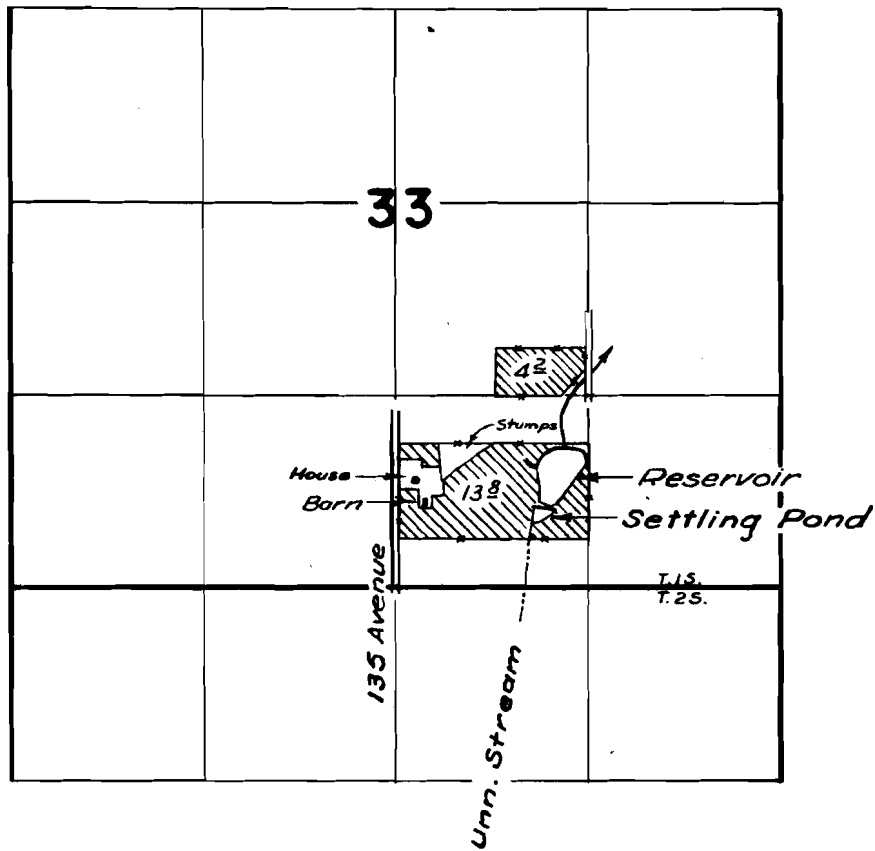

FINAL PROOF SURVEY
UNDER

R-32428 R-2154
Application No. 32427 Permit No. 25599
IN NAME OF

JOE TAYLOR

Surveyed Dec. 24 1962, by m. Bish