


T. I. S. R. I. W. W. M.

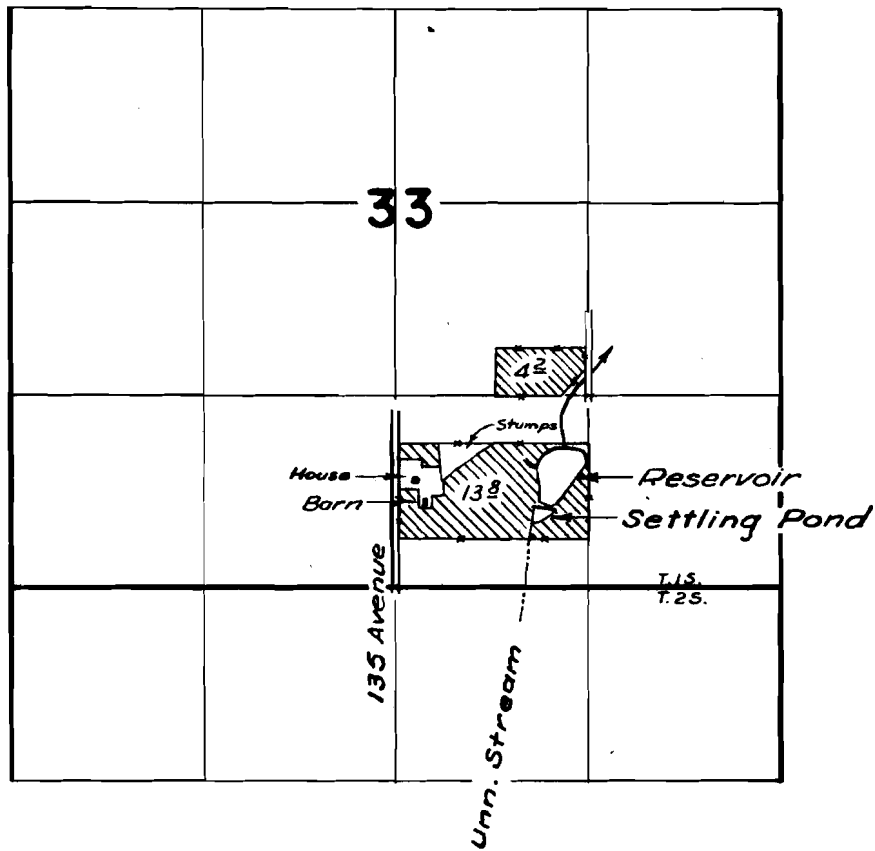

**FINAL PROOF SURVEY**  
UNDER

R-32428                      R-2154  
Application No. 32427    Permit No. 25599  
IN NAME OF

JOE TAYLOR

Surveyed Dec. 24 1962, by m. Bish