


T. 8S. R. 19E. W.M.

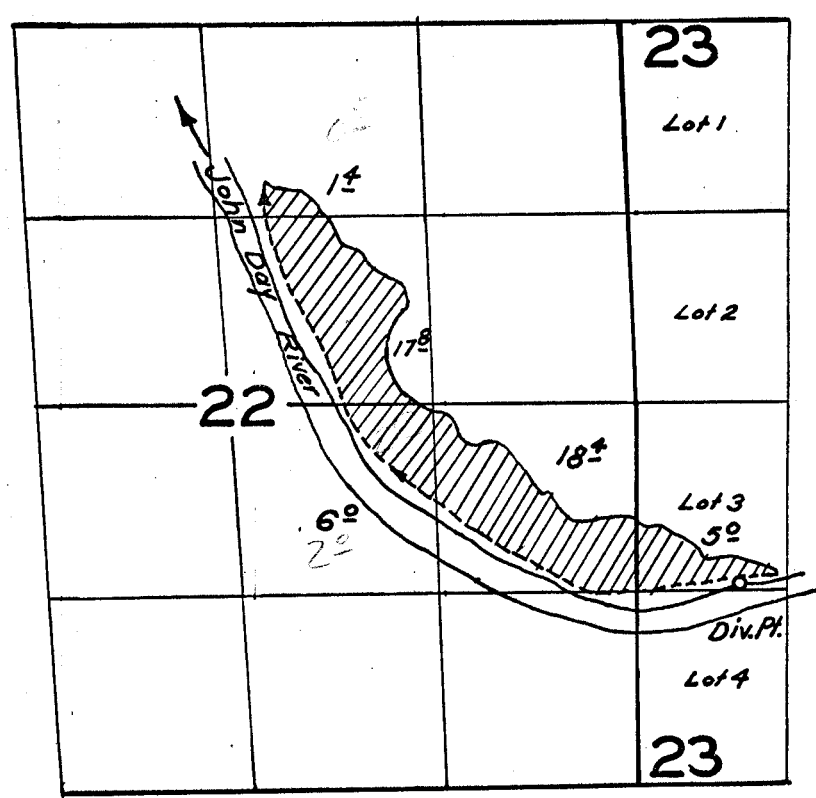

FINAL PROOF SURVEY UNDER

Application No. 34740 Permit No. 27277
IN NAME OF

Willard Rolfe

Surveyed Sept. 26 1962, by Ralph Jackson