


T.5S. R.3W. W.M.

YAMHILL COUNTY

GRAND

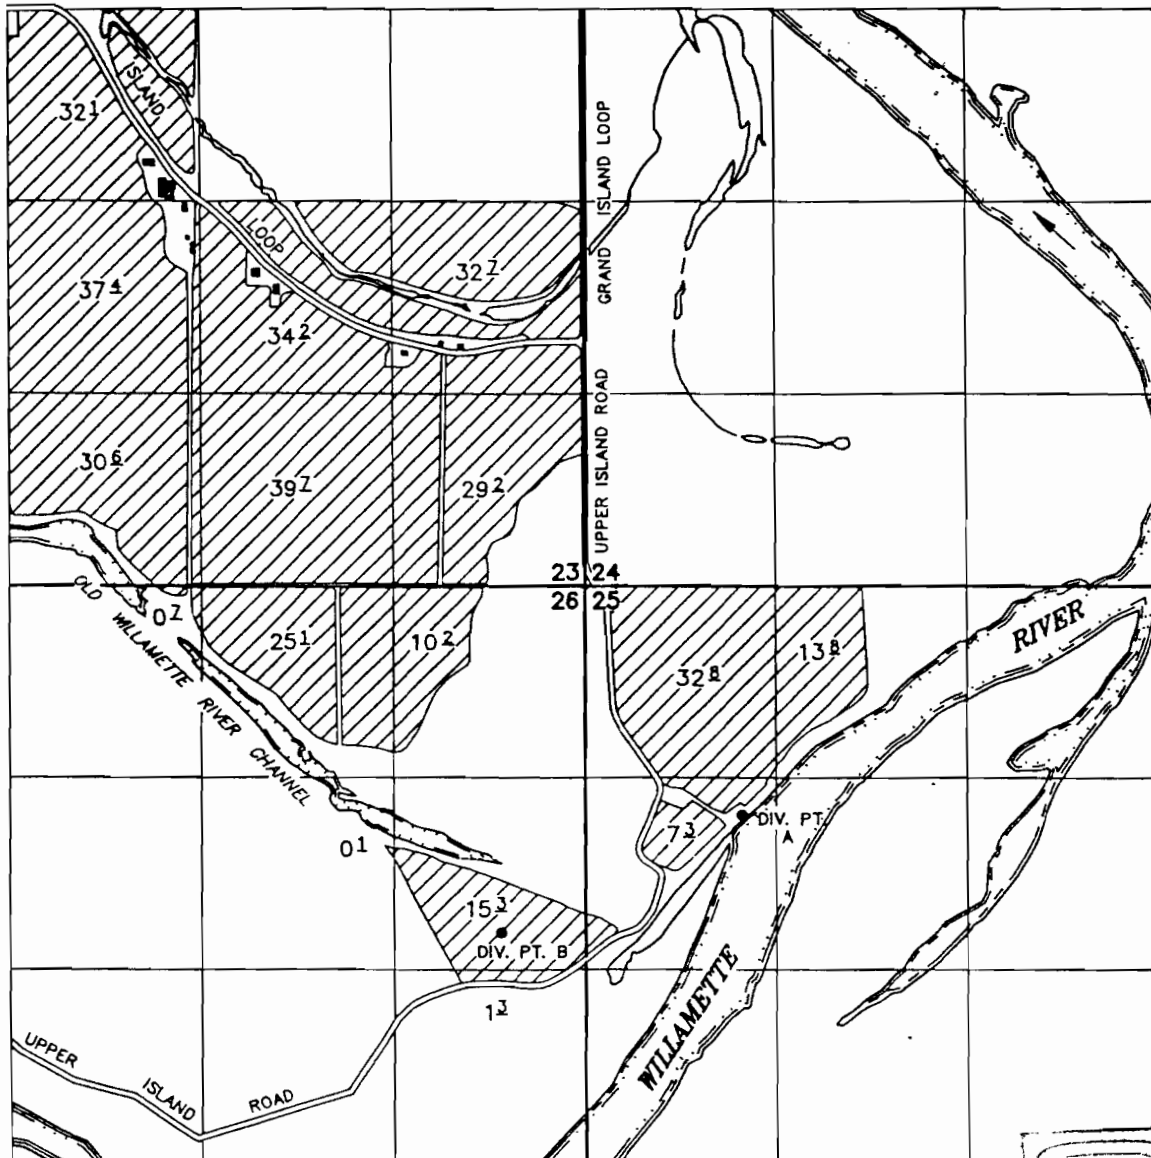

DIV. PT. A: 1585' S AND 1050' E FROM THE NW COR SEC 25
 DIV. PT. B: 2383' S AND 585' W FROM THE NE COR SEC 26

FINAL PROOF SURVEY

UNDER

TAX LOTS:

053W23 00600
 053W23 01100
 053W23 01200
 053W23 01300
 053W25 00100
 053W26 00100
 053W26 00200
 053W26 00800

GR-1540
 GR-1541
 GR-1542
 GR-3155
 GR-3156
 GR-3276
 GR-3568
 G-1476
 17944
 17950
 30616

GR-1483
 GR-1484
 GR-1485
 GR-2961
 GR-2962
 GR-3276
 GR-3277
 G-1354
 13625
 13631
 24121

31301
 13772
 13774

Application No. S-72039 Permit No. 52060 Certificate No. _____

A & R SPADA FARMS

NOTE: This map is for the purpose of identifying the location of water rights and has no intent to dimension or locate property ownership lines.

SEPTEMBER 14, 1999

SCALE: 1" = 1320'

