


T.3S.R.2W.W.M.

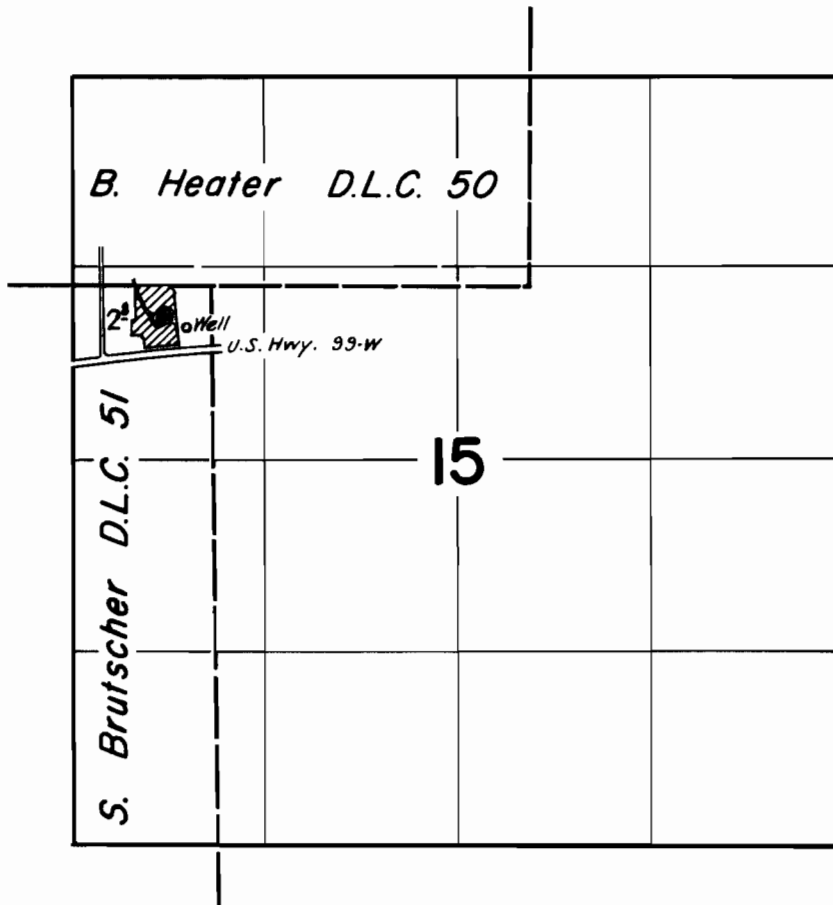

FINAL PROOF SURVEY UNDER

Application No. G-1711..... Permit No. G-1571.....
IN NAME OF

.....ALFRED J. CORMACK.....

Surveyed July 26 1962., by *Al Jackson*