


T.48&5S.R.4W.W.M.

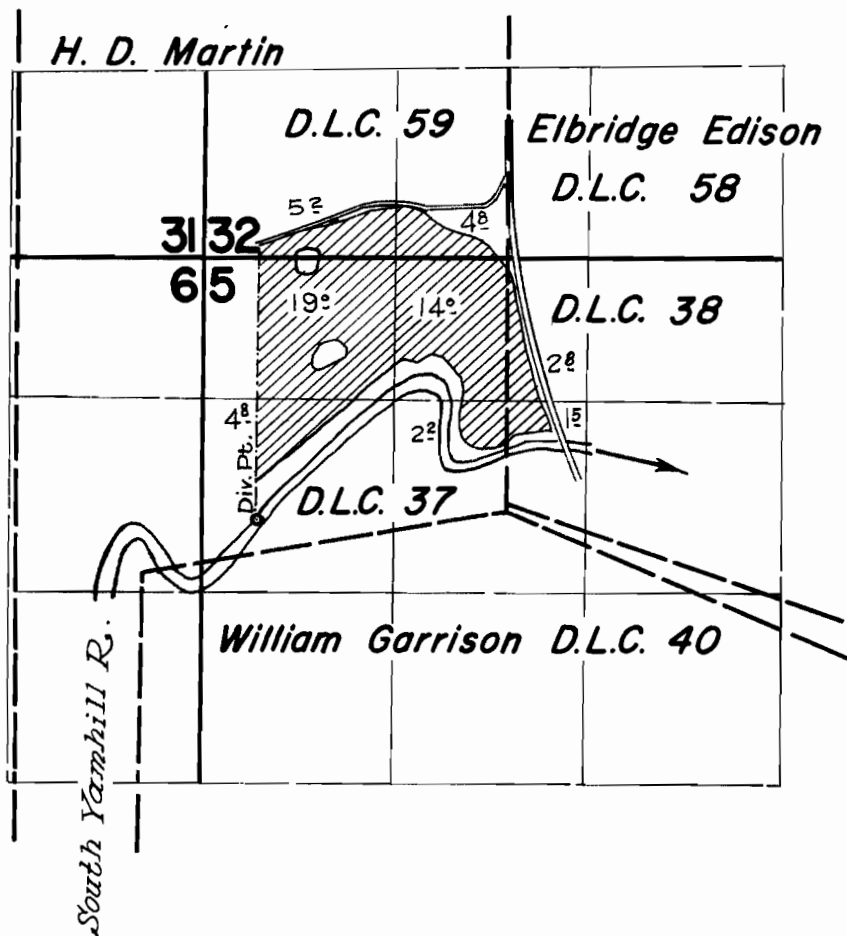

FINAL PROOF SURVEY
UNDER

Application No. **31452** Permit No. **24802**
IN NAME OF

DR. B. A. WHITE

Surveyed August 27 1962, by *[Signature]*