


T.3S.R.2W.W.M.

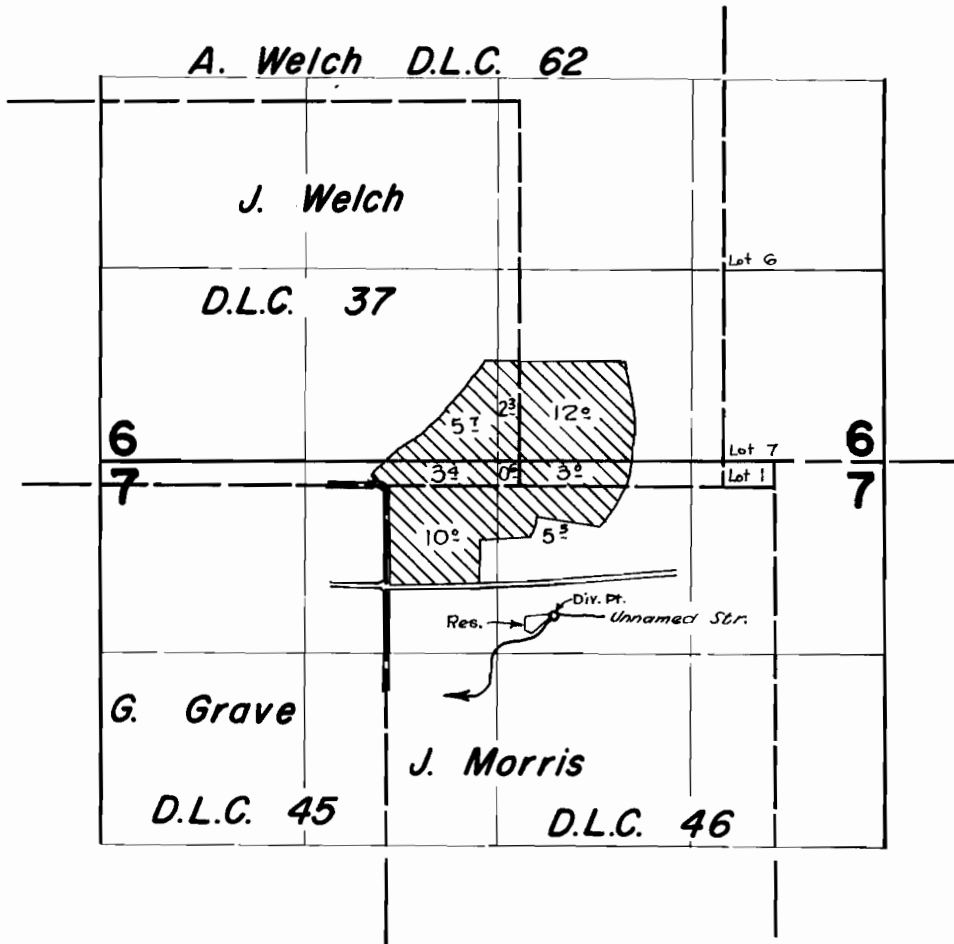

FINAL PROOF SURVEY UNDER

Application No. 32211 Permit No. 25416
IN NAME OF

KENNETH W. KJERSTEN

Surveyed July 27, 1962, by