


T.4S.R.5W.W.M.

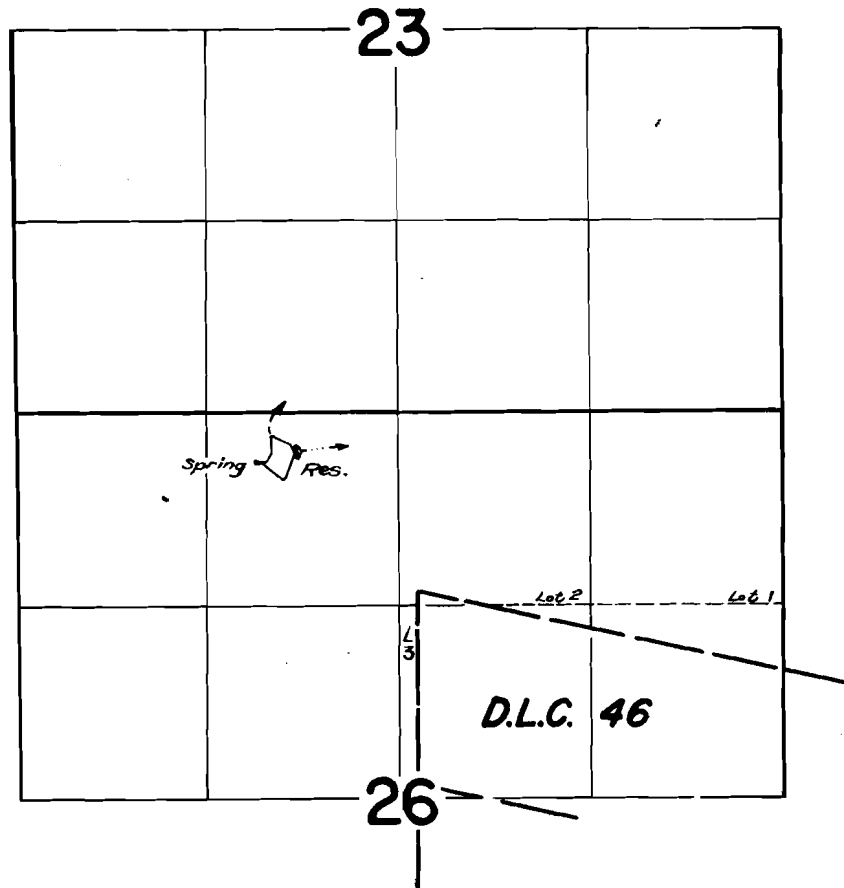

FINAL PROOF SURVEY
UNDER

R-31550 R-2163
Application No. **31551** Permit No. **25661**
IN NAME OF

HARRY C. YOUNGBERG

Surveyed August 29 1962, by *[Signature]*