


T.4S.R.5W.W.M.

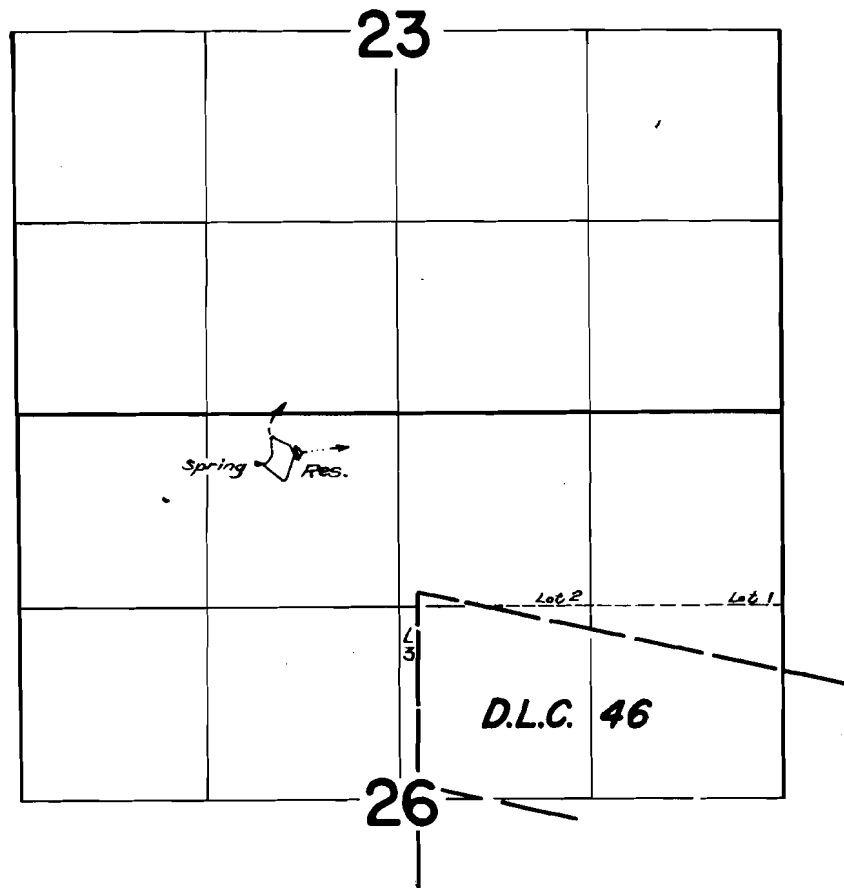

FINAL PROOF SURVEY
UNDER

R-31550 R-2163
Application No. 31551 Permit No. 25661
IN NAME OF

HARRY C. YOUNGBERG

Surveyed August 29 1962, by *[Signature]*