


T.4S.R.5W.W.M.

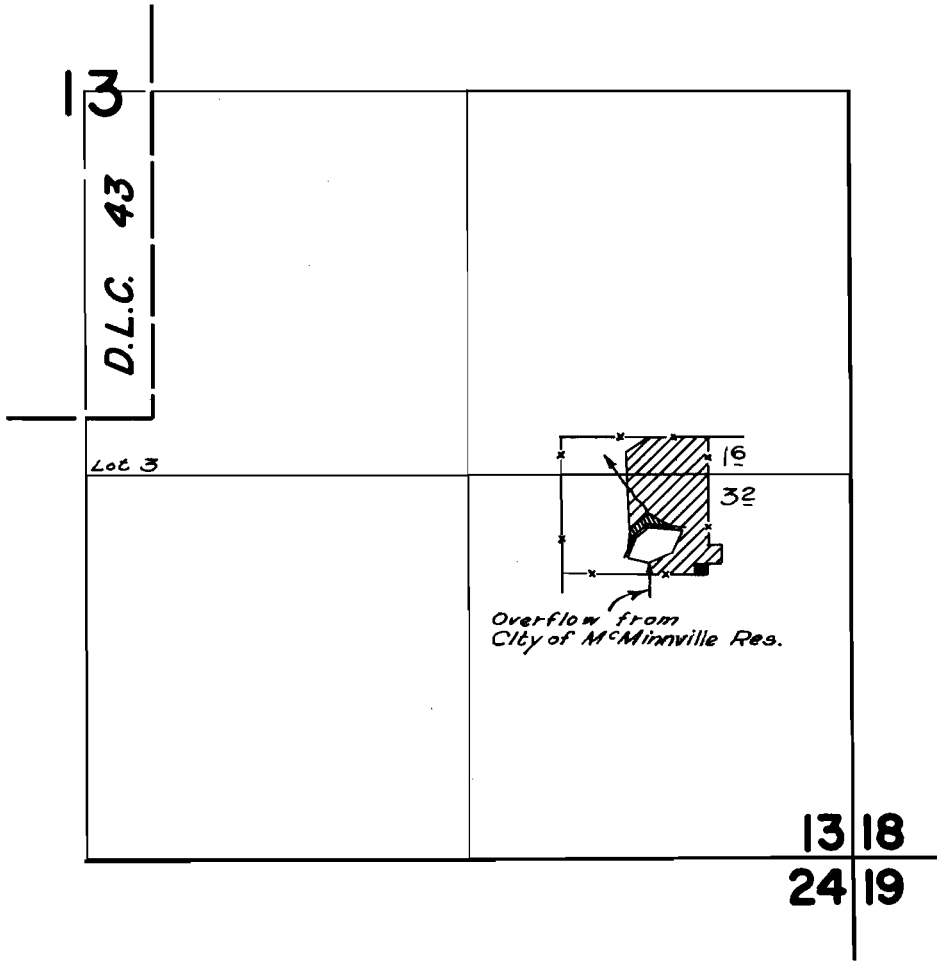

FINAL PROOF SURVEY
UNDER

R-25898 R-2222
Application No. 25899 Permit No. 25985
IN NAME OF

GORDON HAYNES

Surveyed *Sept. 7, 1962*, by *[Signature]*