


T.4S.R.5W.W.M.

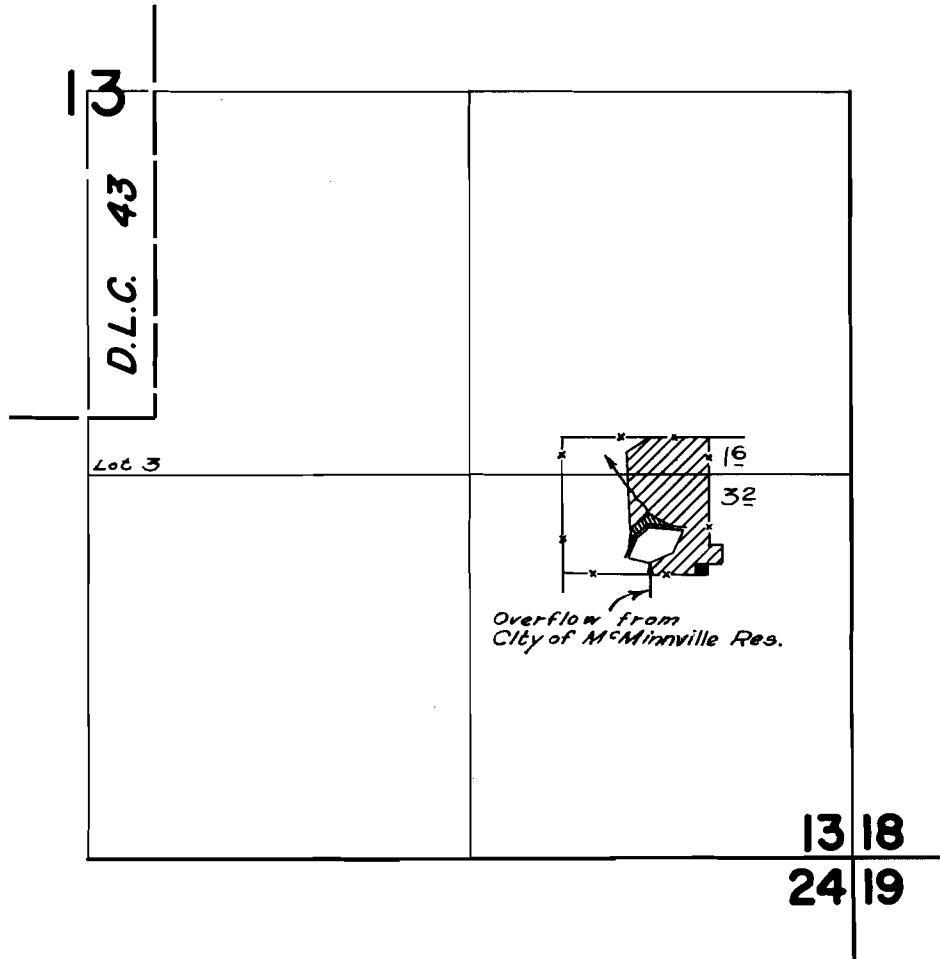

FINAL PROOF SURVEY
UNDER

R-25898 R-2222
Application No. 25899 Permit No. 25985
IN NAME OF

GORDON HAYNES

Surveyed Sept. 7, 1962, by *A. Jackson*