


T.4 S.R.3 W.W.M.

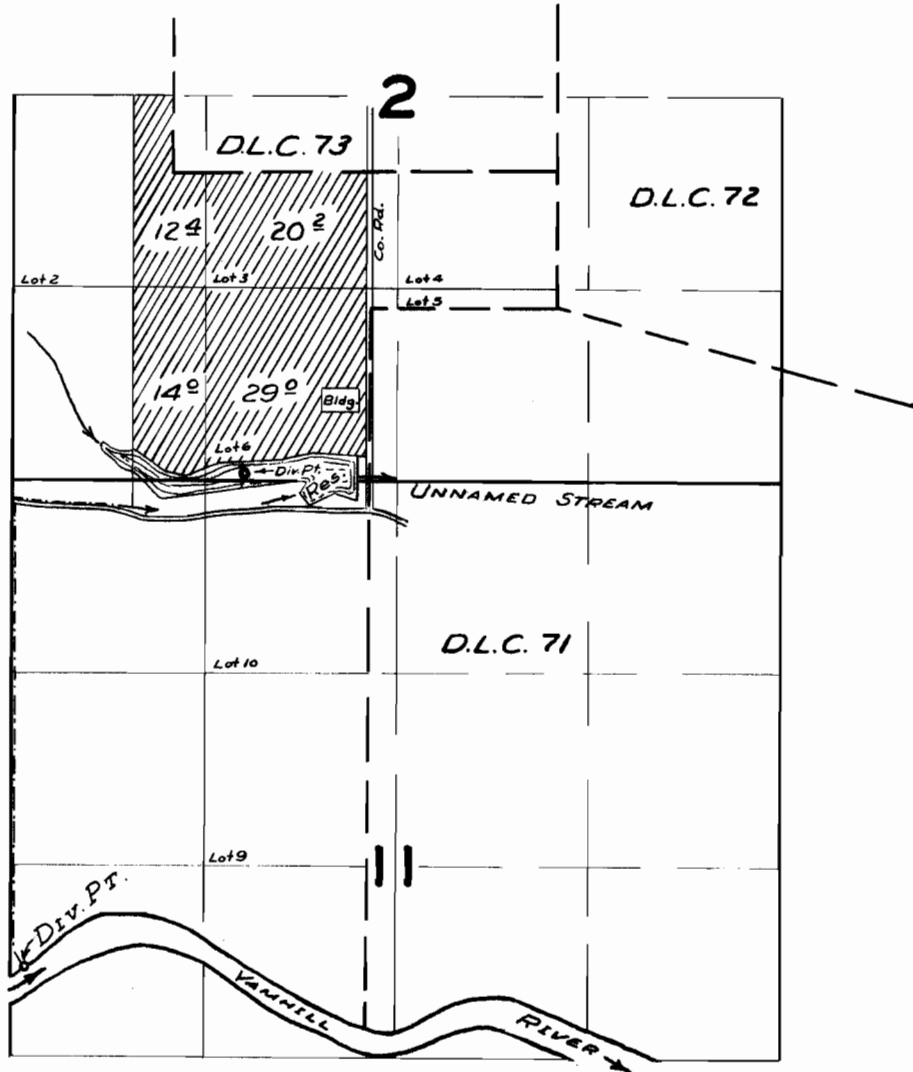

FINAL PROOF SURVEY UNDER

Application No. 33284 Permit No. 26271
IN NAME OF

PHILLIP A. HAWMAN

Surveyed 3 JUNE 1960, by Ms. Bush
25 JULY 1962, by R. Jackson