


T. 4 S. R. 3 W. W.M.

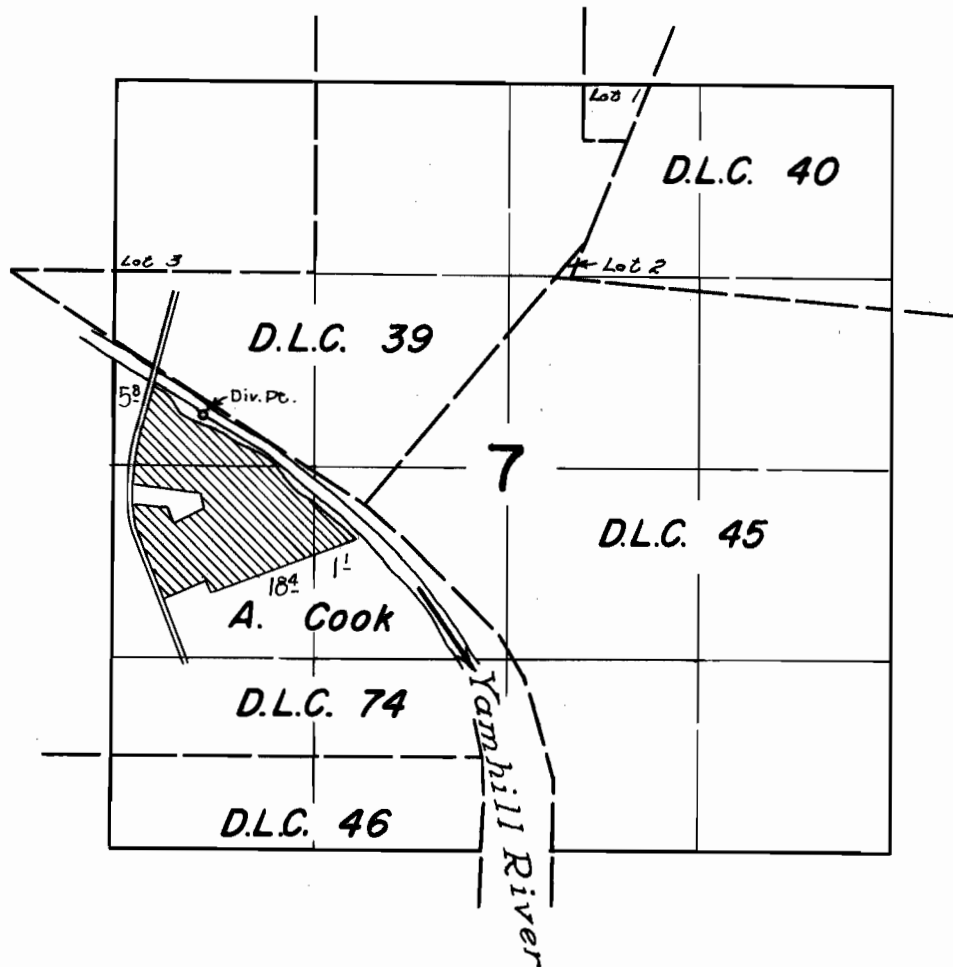

FINAL PROOF SURVEY
UNDER

Application No. 33873... Permit No. 26698...
IN NAME OF

DAVID E. ERICKSON

Surveyed July 25, 1962, by *David E. Erickson*