


T.4S.R.3W.W.M.

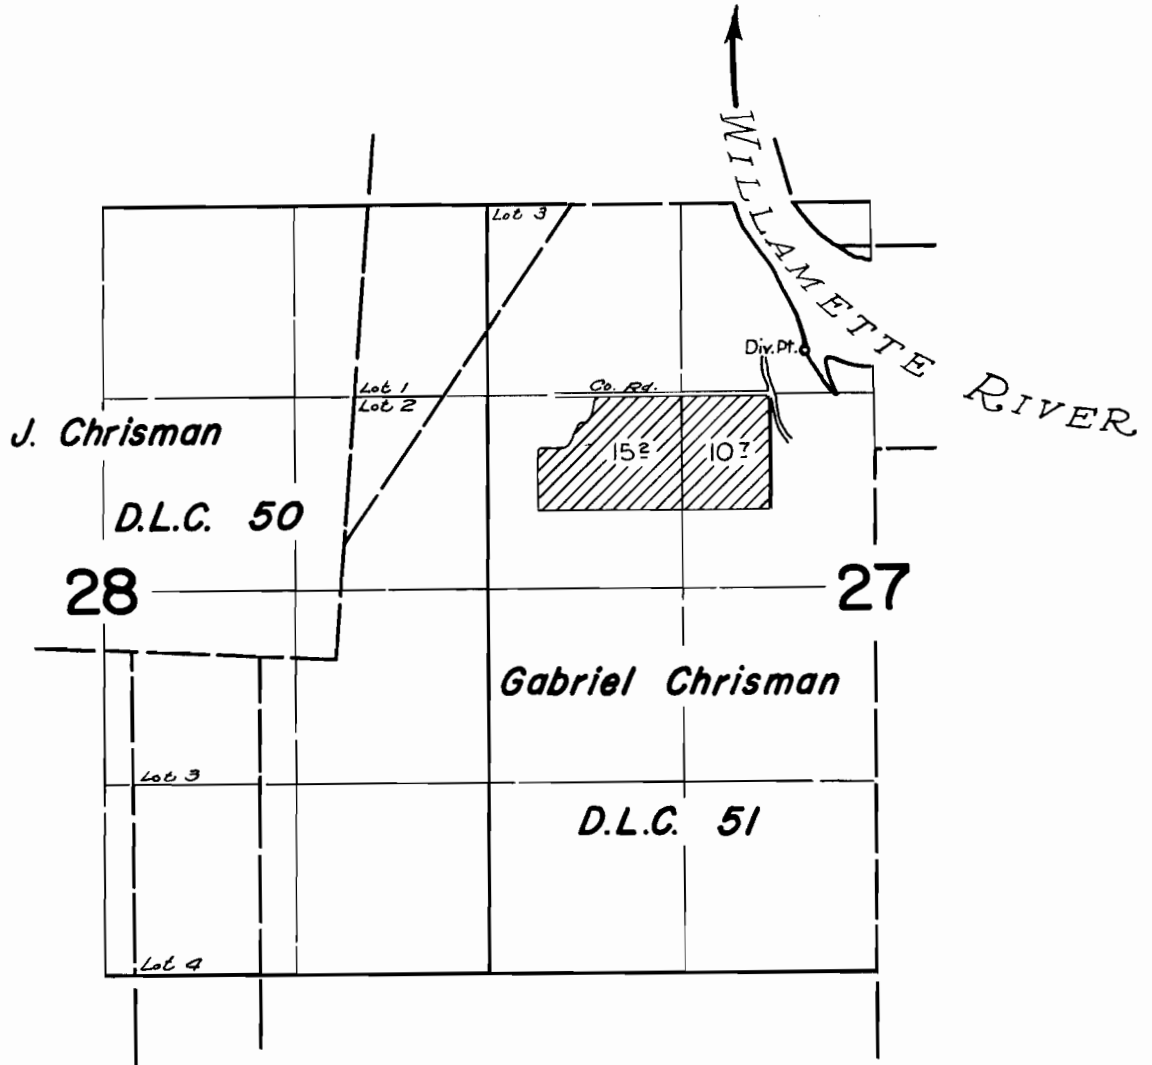

FINAL PROOF SURVEY
UNDER

Application No. **34610**... Permit No. **27176**....
IN NAME OF

JOHN E. LITSCHER

Surveyed July 24, 1962, by *Al Peterson*