


T.4S.R.4W.W.M.

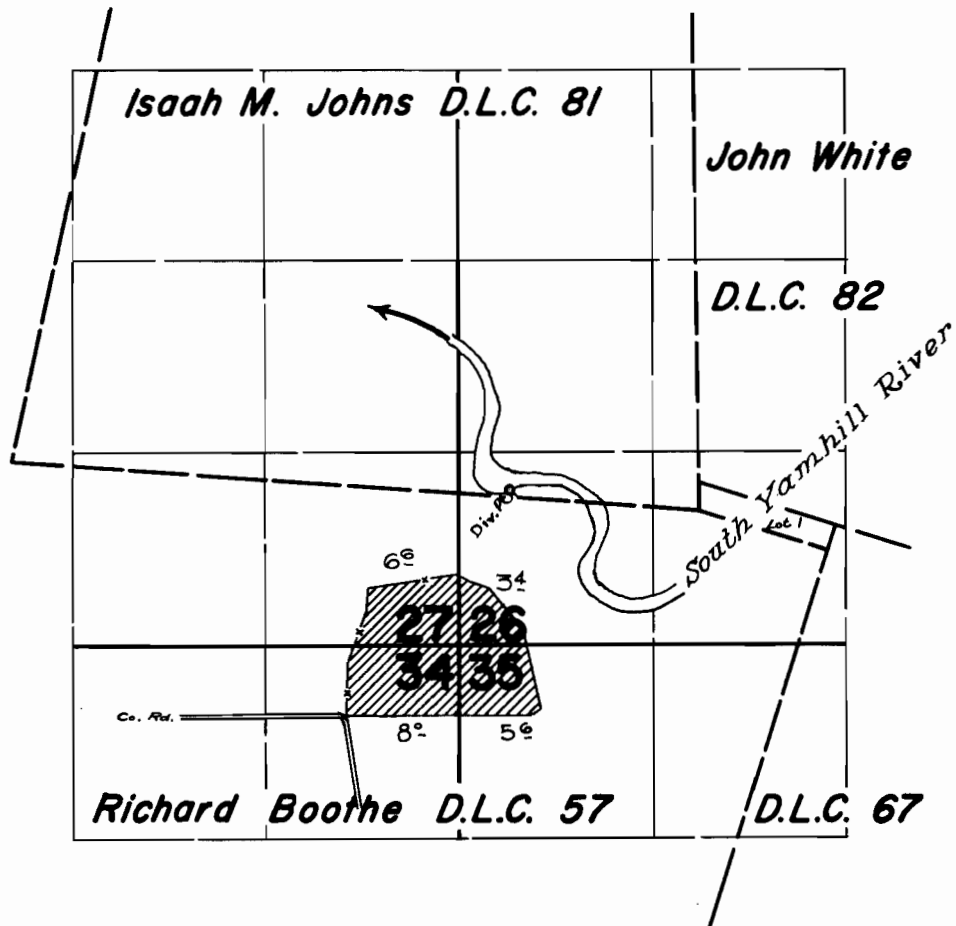

FINAL PROOF SURVEY UNDER

Application No. **34828** Permit No. **27346**
IN NAME OF

RUSSELL L. OLSON

Surveyed August 27 1962, by *R. Jackson*