


T.5S.R.3W.W.M.

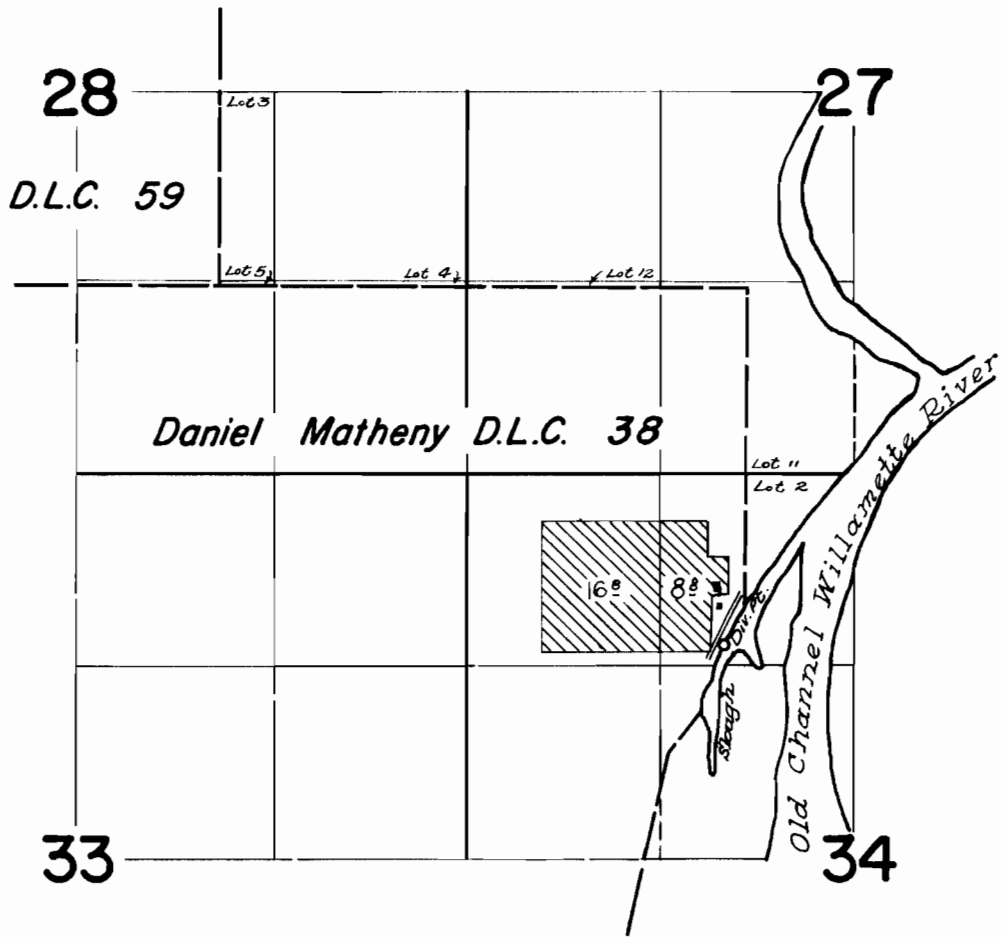

FINAL PROOF SURVEY
UNDER

Application No. **37044** Permit No. **27567**
IN NAME OF

EVELYN L. TERRY

Surveyed August 30 1962, by *[Signature]*