


T. 4 S. R. 3 W. W. M.

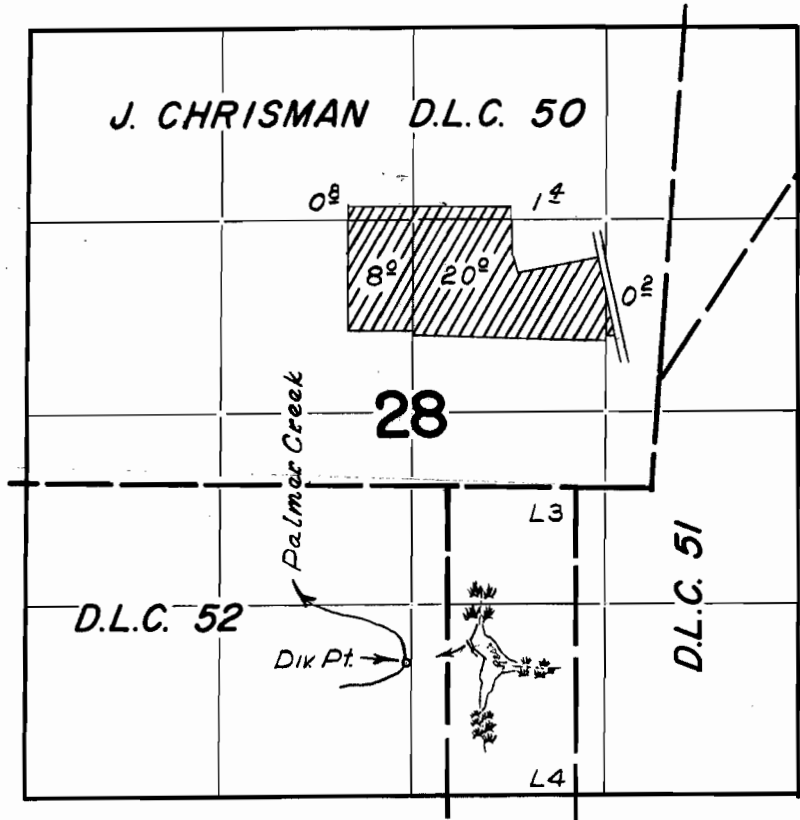

FINAL PROOF SURVEY UNDER

R-32100 *R-2116*
Application No. *32101* Permit No. *25363*
IN NAME OF

..... **C. F. RUTSCHMAN**

Surveyed *24 May 1960*, by *M. Bish*.....
24 July 1962, by *R. Jackson*