


T. 5 S. R. 5 W. W. M.

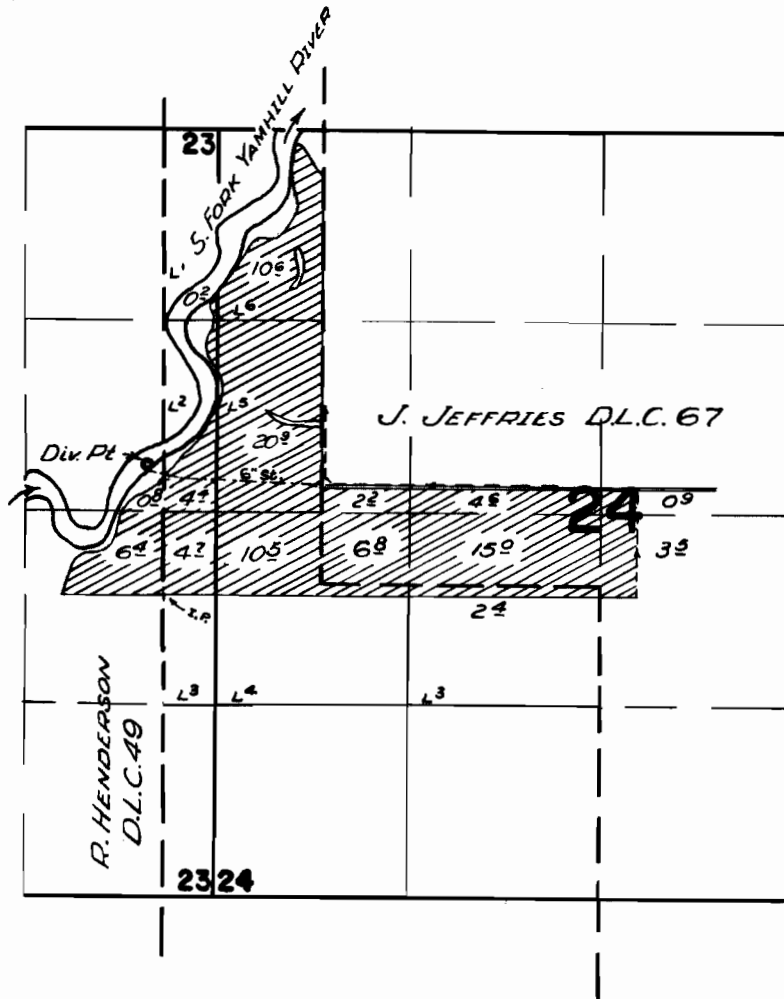

**FINAL PROOF SURVEY**  
UNDER

Application No. 32786 Permit No. 25867  
IN NAME OF

LEHMAN BROS.

Surveyed 25 APRIL 1961, by m. B. S.  
8 October 1962 by R. Jackson