


# T.4S.R.5W.W.M.

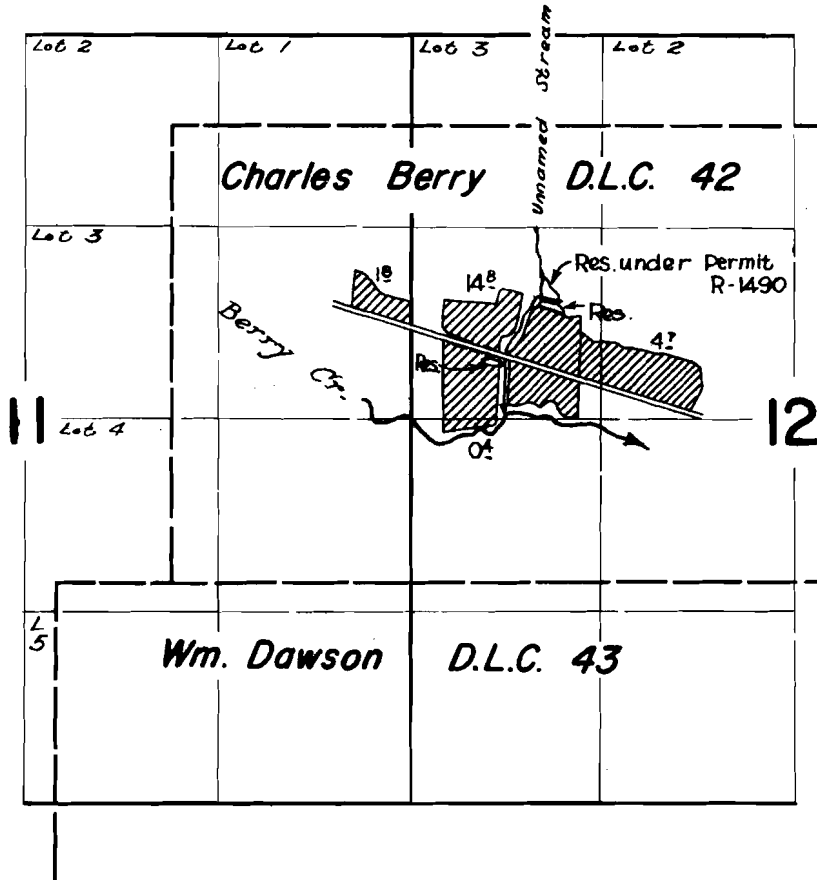

## FINAL PROOF SURVEY UNDER

R-33102 R-2243  
Application No. 33103 Permit No. 26168  
IN NAME OF

CARTER & HELEN KVAVLE

Surveyed August 28 1962, by